


#22214-V



4-00-019-A

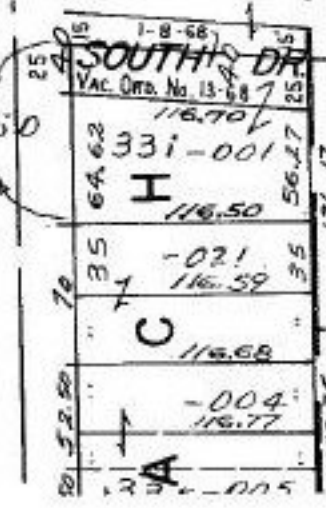

ELECTRIC 555.77

T.A. LANE

#22214-V

FRONTAGE CORRECTION
 (-001) TO INCLUDE PART
 OF SOUTH DR. (VACATED)
 BY ORDINANCE # 13-68

FRONTAGE CORRECTION
 (-050) TO INCLUDE PART
 OF NORTH DR. (VACATED)
 BY ORDINANCE # 12-68

APPROVED
 LORAIN CO.
 MAP DEPT

DATE 6-13-97

PAGE 4-00-019B

BY R. BELL
 #22214-V