


#22220  
NO. 22220

PARENT PARCEL: 19-01-061-000-012  
CHILD PARCEL: 19-01-061-000-013, 014  
STARTING POINT: c.l. of Foster Rd. & nw corner of O.L. 61



O.L. 58 TR. 2

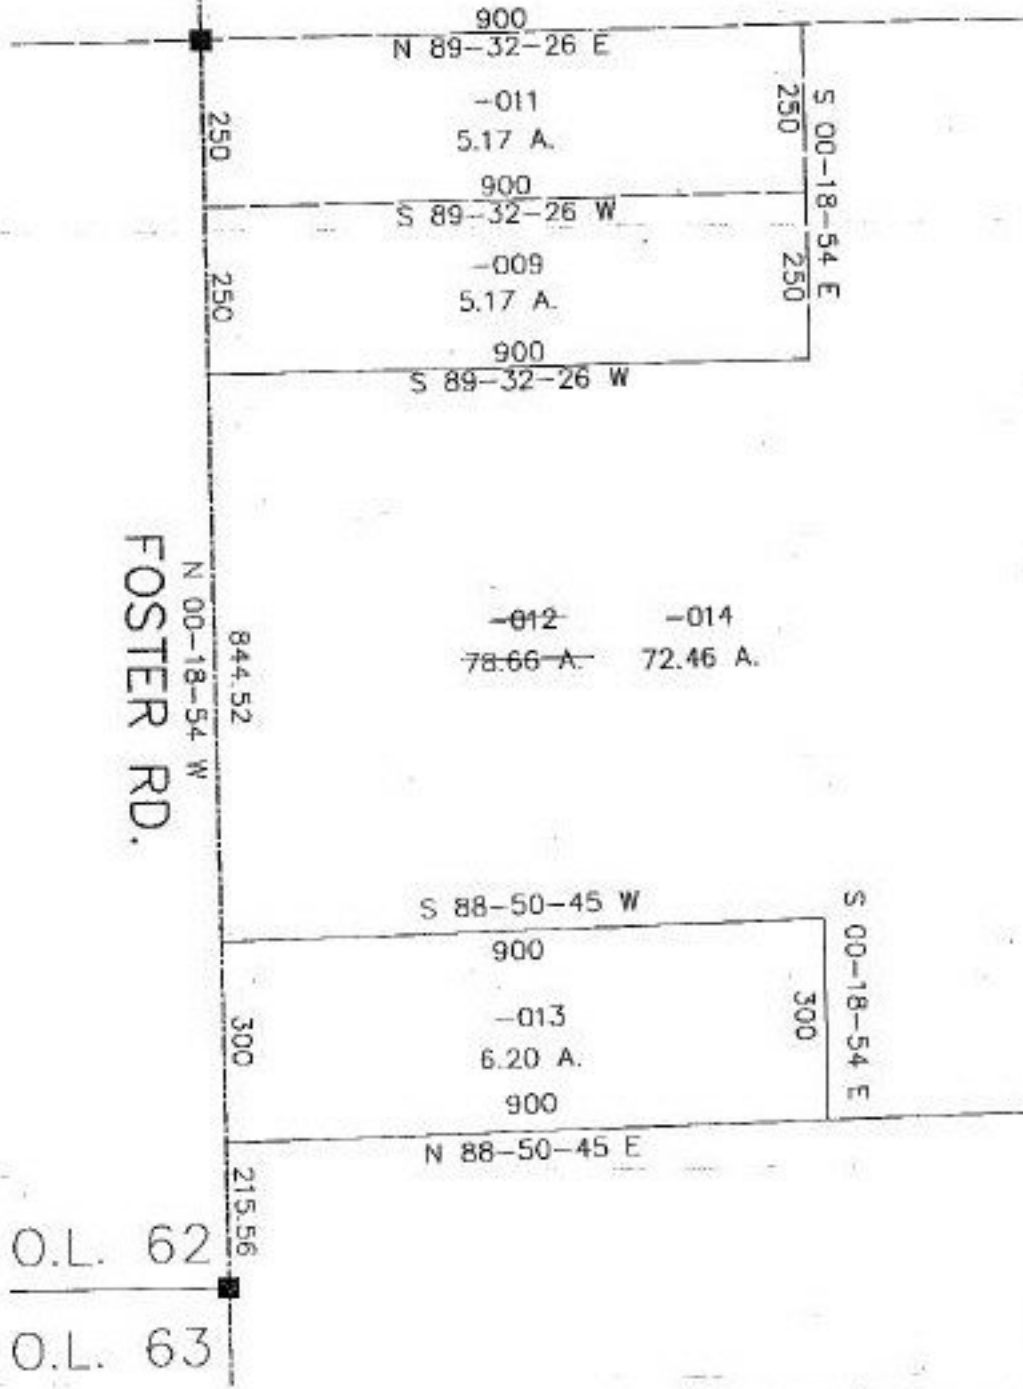

SPLITS/DEEDS PROCESSED  
LORAIN COUNTY TAX MAP DEPARTMENT  
226 MIDDLE AVE. ELYRIA, OHIO

SURVEYED BY: Rodger G. Simon  
CLOSURE: 0.00 per 10,000  
MAP PAGE(S): 19-H  
APPROVED BY: kac DATE: 7/30/97  
SCALE: 1" = 300'