

#22222

NO. 22222


PARENT PARCEL: 11-00-007-000-067
CHILD PARCEL: 11-00-007-000-075, 076 & 077
STARTING POINT: INT CL COOLEY ROAD & HAWKE ROAD



TO P.O.B.
COOLEY ROAD
2107.20
S 02-08-37 W.

HAWKE ROAD

COMBINATION PER SURVEY
BY JAMES B. ROOT

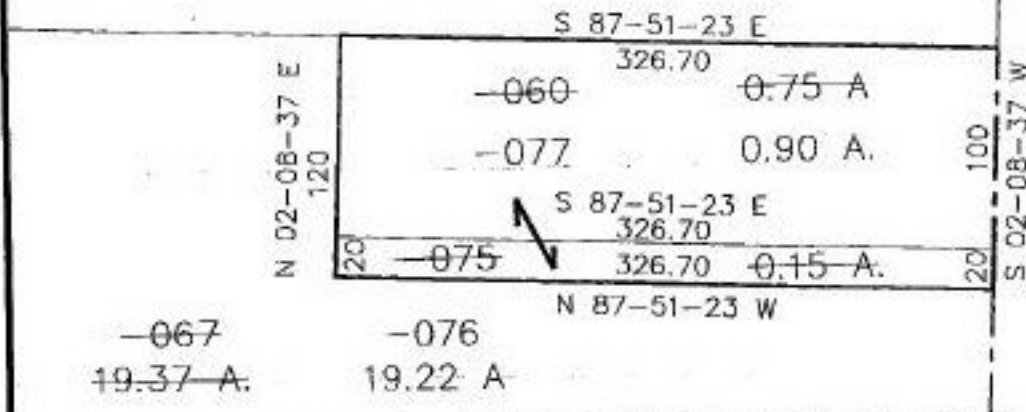

SPLITS/DEEDS PROCESSED
LORAIN COUNTY TAX MAP DEPARTMENT
226 MIDDLE AVE. ELYRIA, OHIO

SURVEYED BY: JAMES B. ROOT
CLOSURE: 0.00 : 10.000
MAP PAGE(S): 11-00-007 B
APPROVED BY: RFB DATE: 07/01/97
SCALE: 1" = 100