


SEE 5-00-1

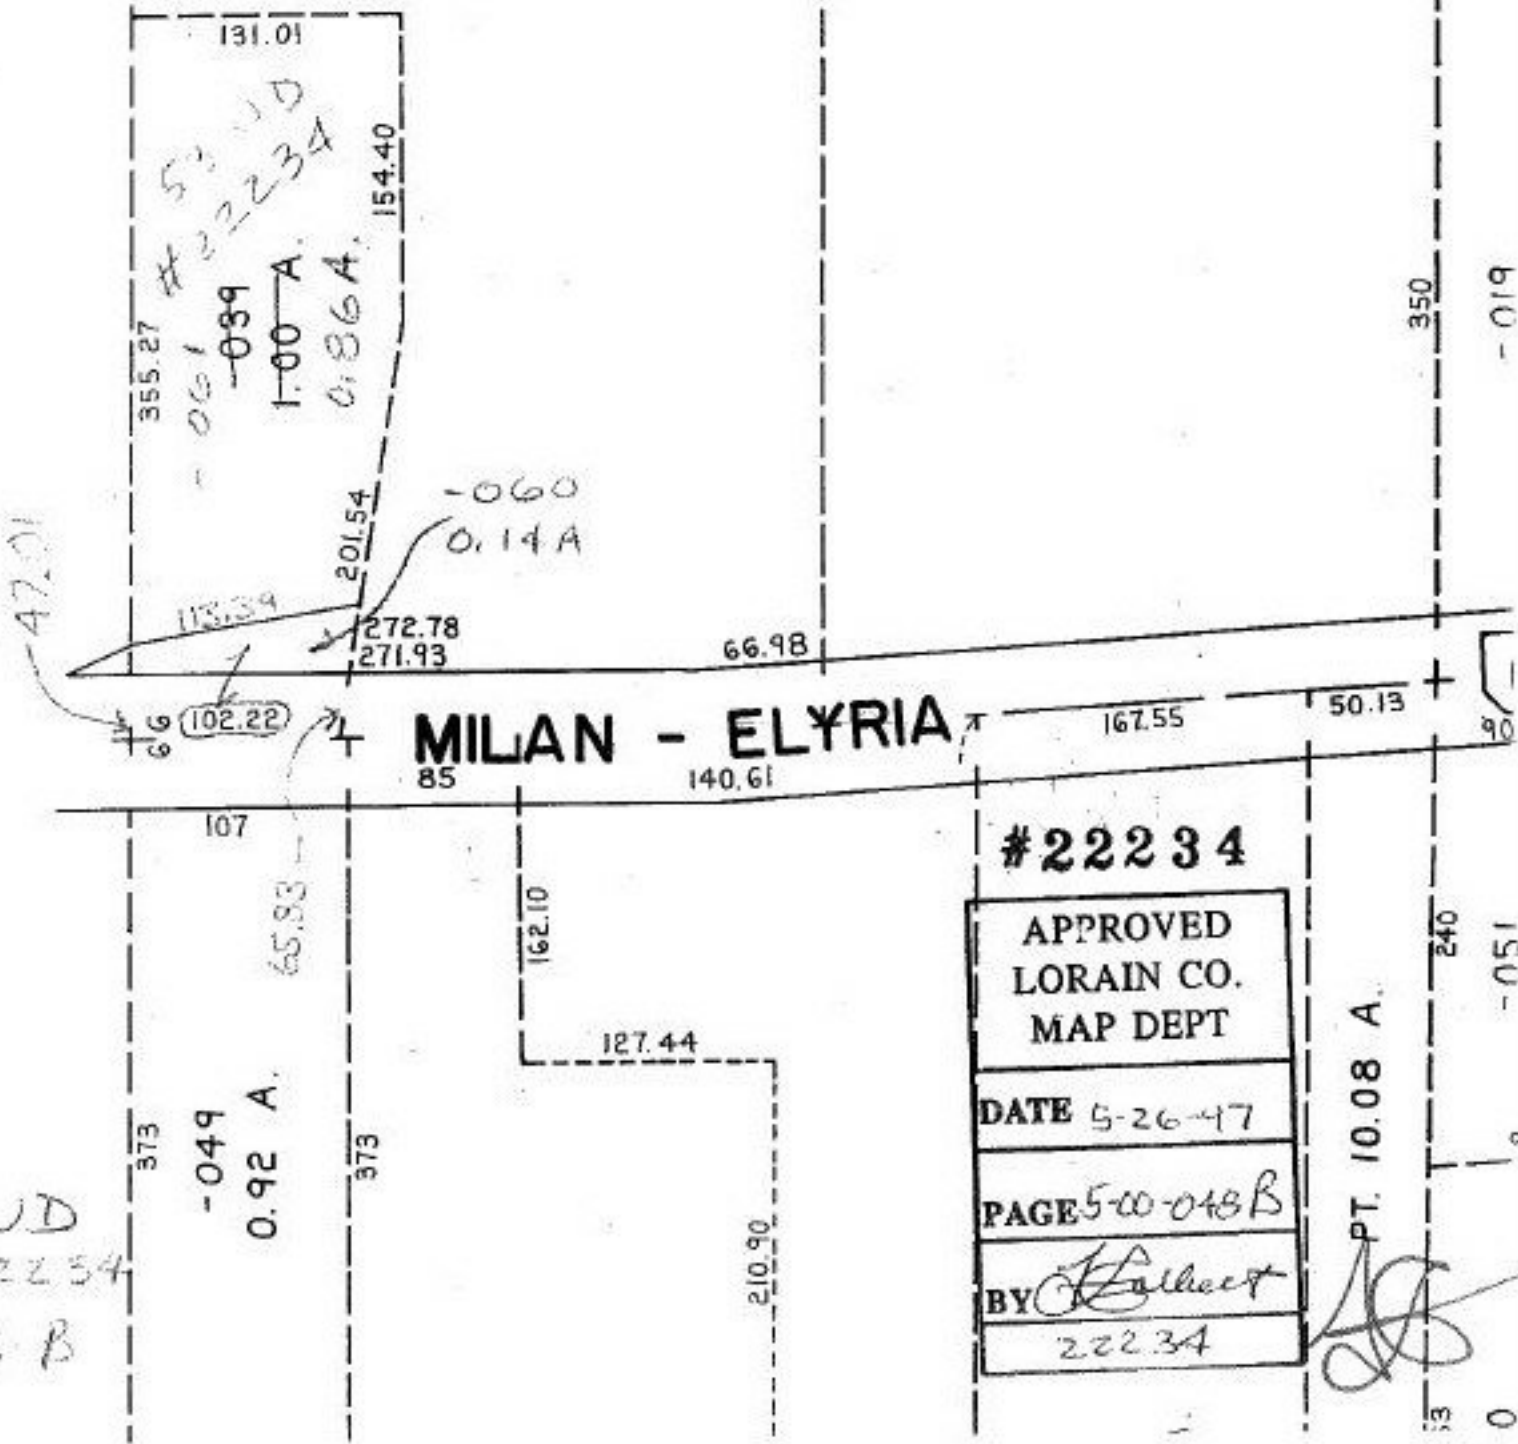

S3WD  
#22234  
048 B

MILAN - ELYRIA

#22234

APPROVED  
LORAIN CO.  
MAP DEPT

DATE 5-26-47

PAGE 5-00-048 B

BY *[Signature]*  
22234

PT. 10.08 A.

350  
-019  
90  
240  
-051  
13  
0