


BYPASS

- 001
 3.15A. - Dup.#1
 2.22A. - Dup.#2
5.37A. - Total

117

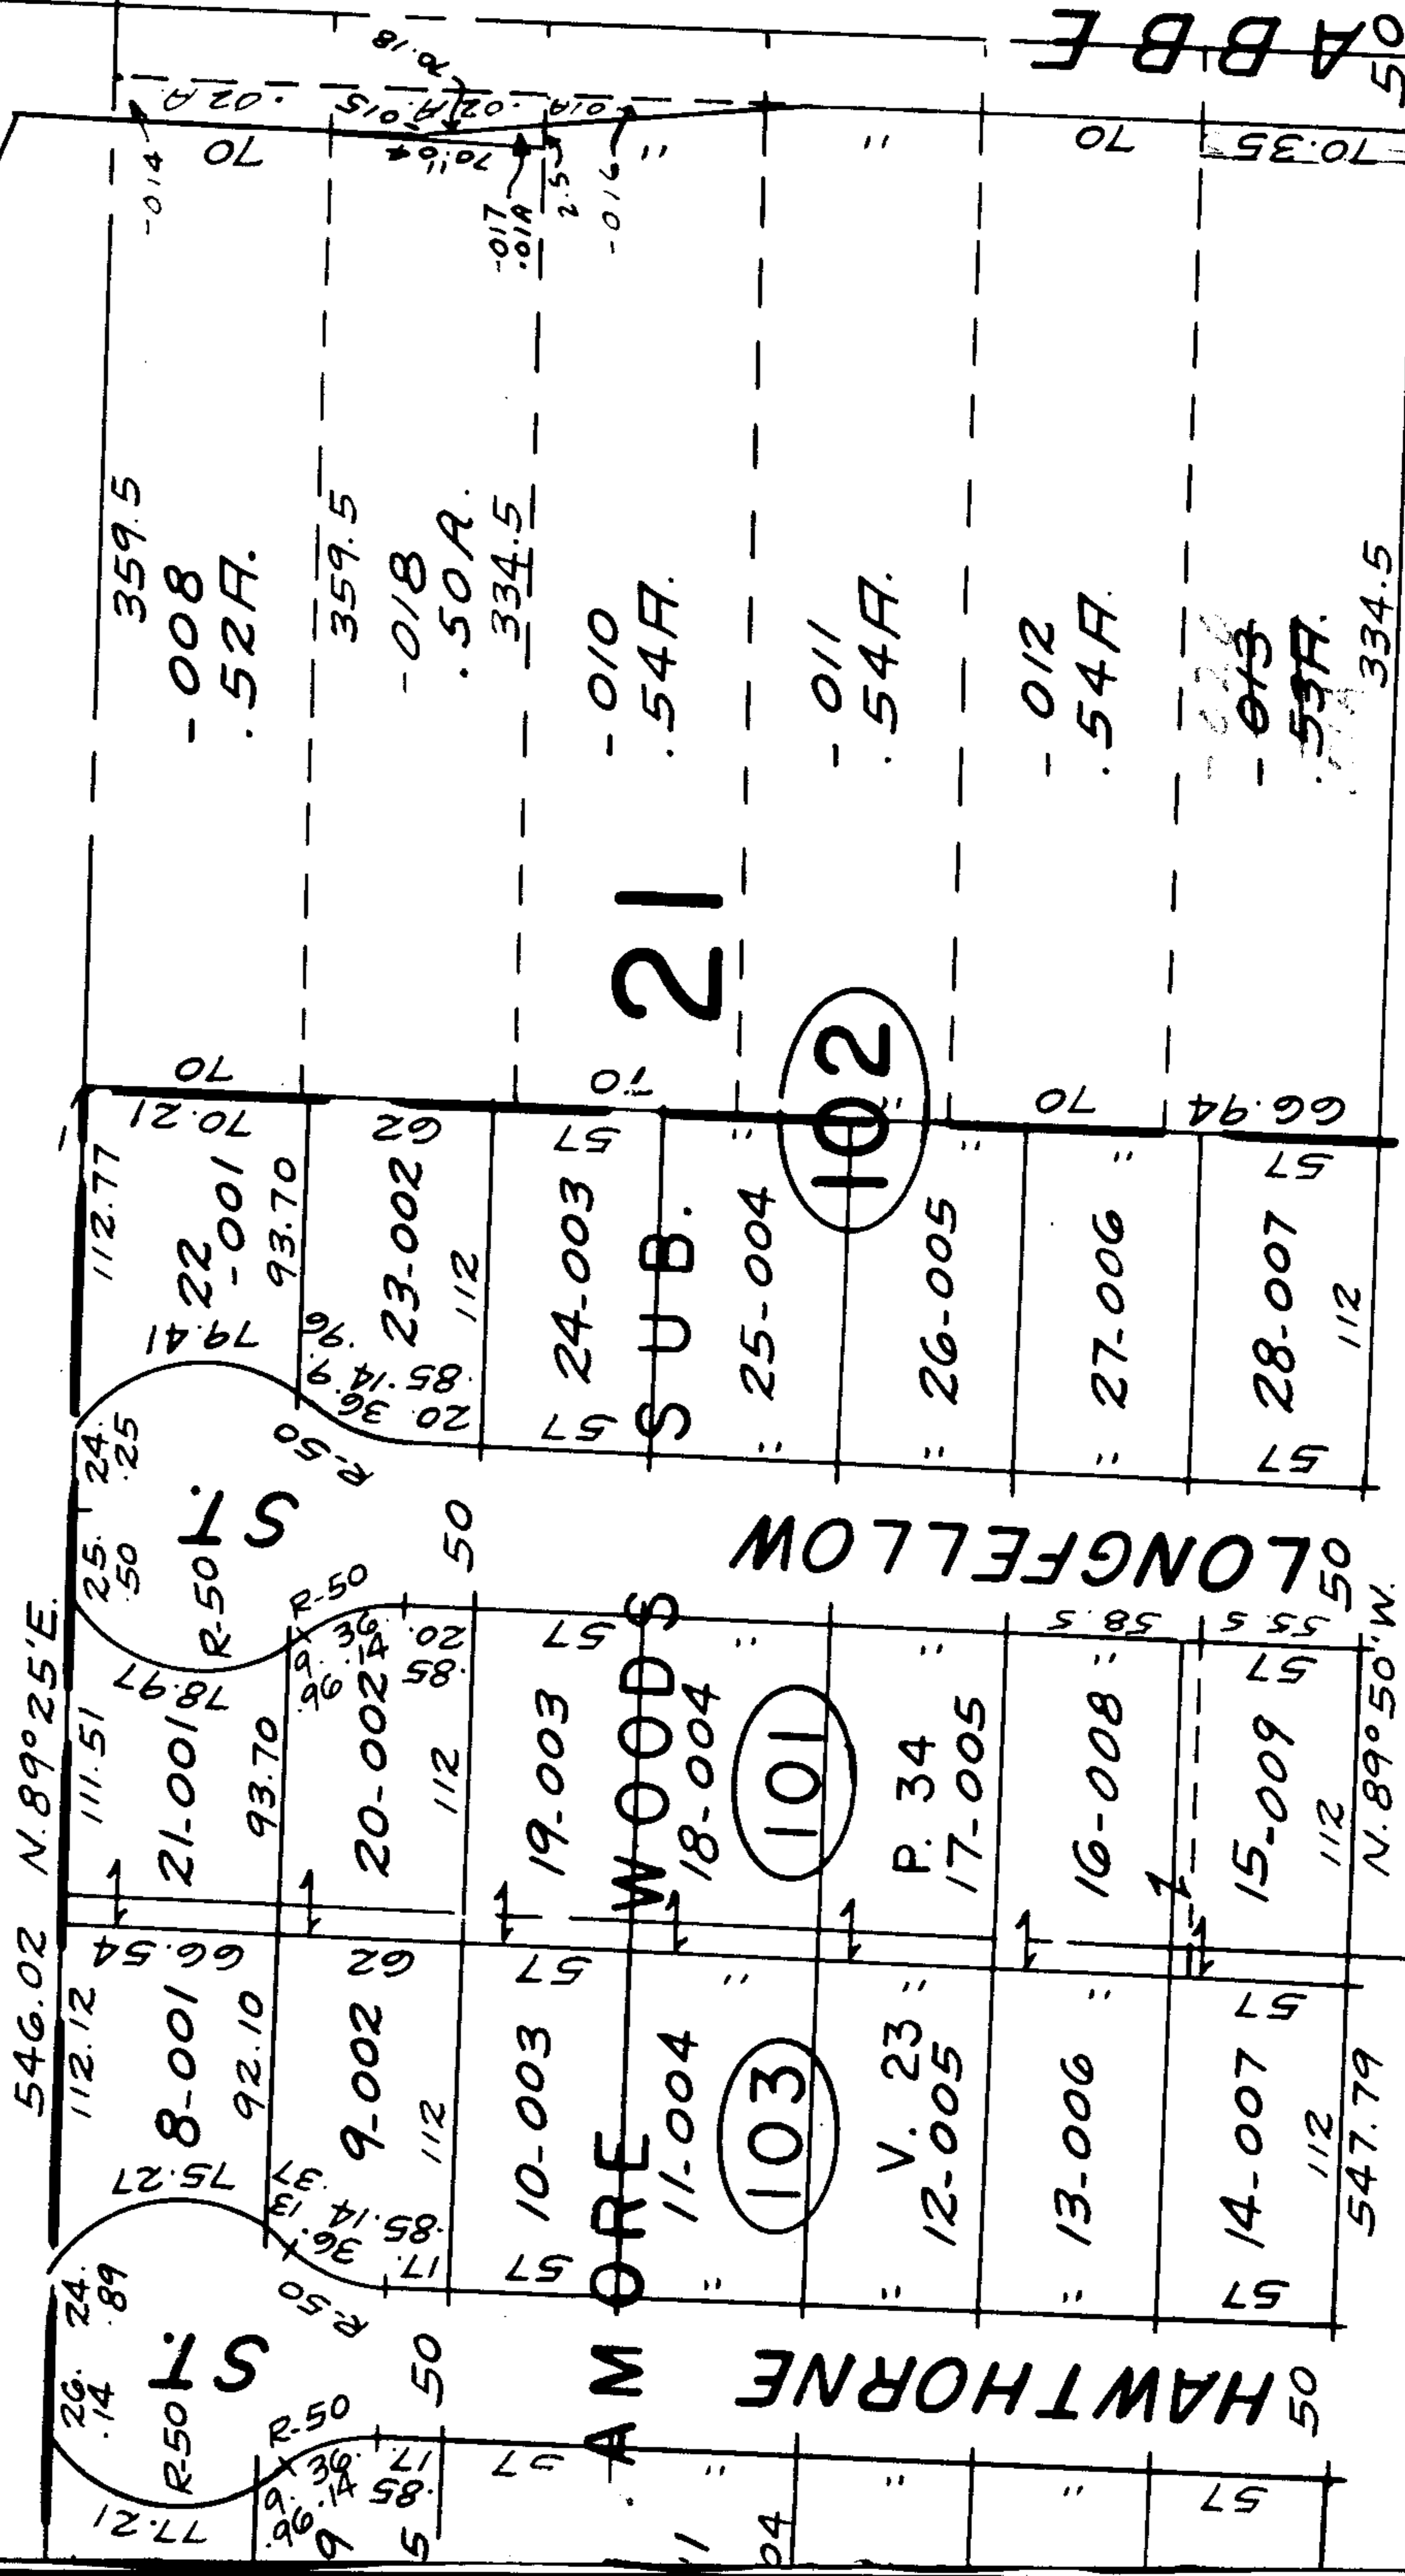

(Handwritten signature)

2224

APPROVED
LORAIN CO.
MAP DEPT.
DATE <u>11/6/78</u>
BY <u>R. Bell</u>

E 6-88

EXAMPLE

ST. 9

ST. 10