


#22 244

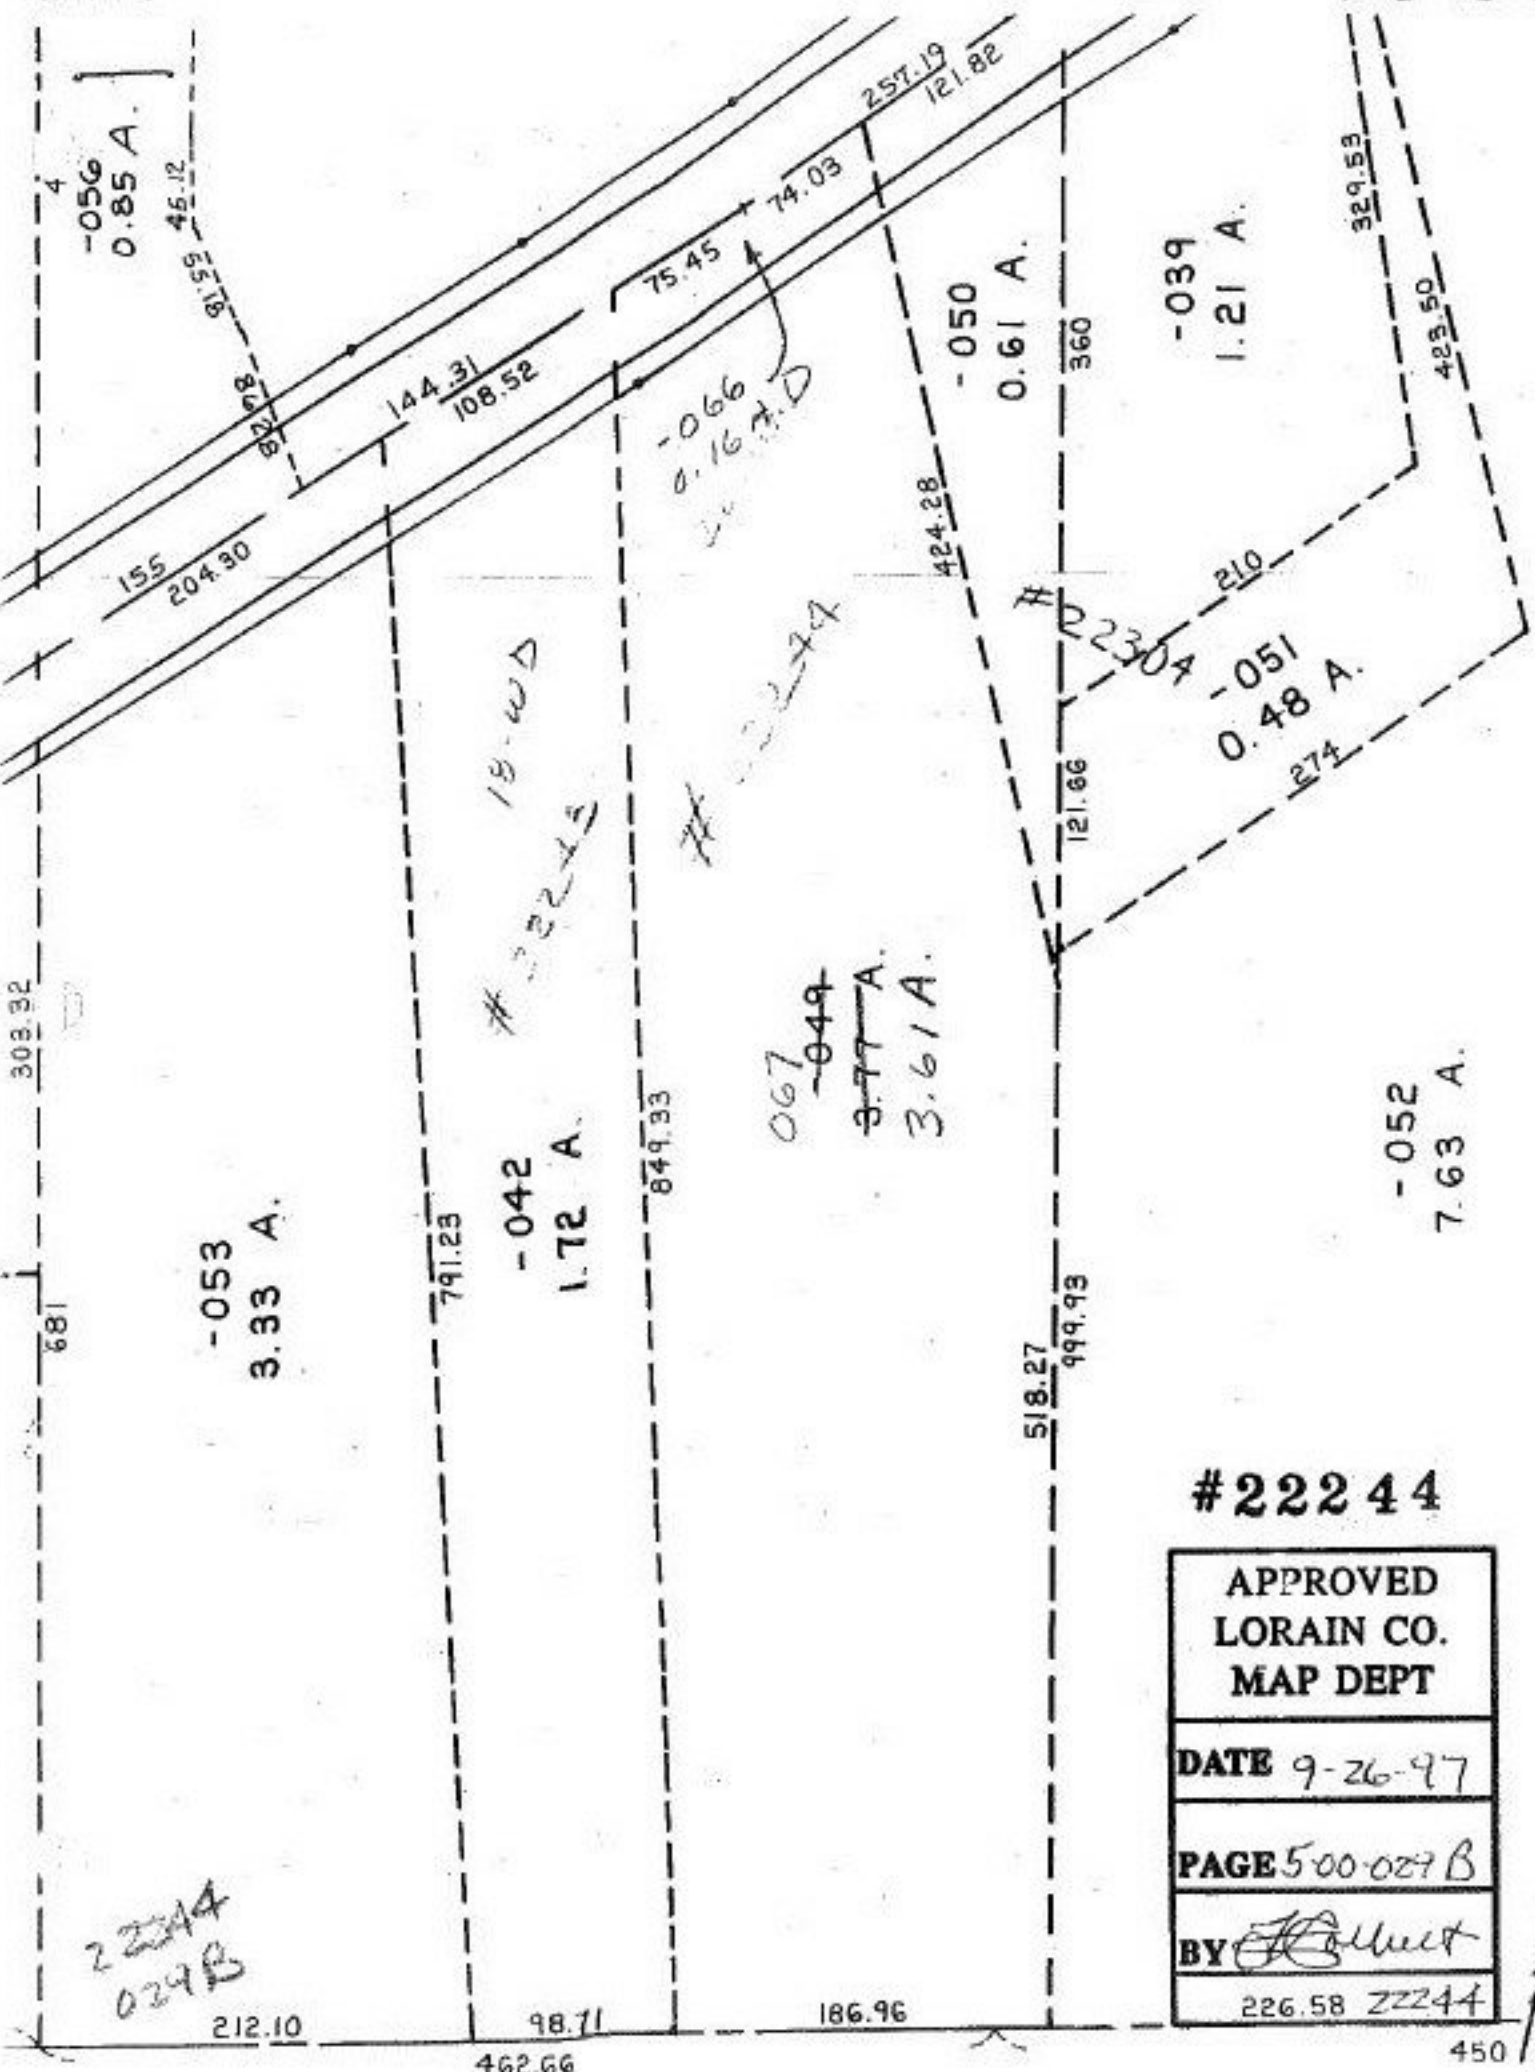

#22244

APPROVED LORAIN CO. MAP DEPT
DATE 9-26-97
PAGE 500-029 B
BY <i>[Signature]</i>
226.58 Z2244

22244
029B

3094.30
[Signature]