
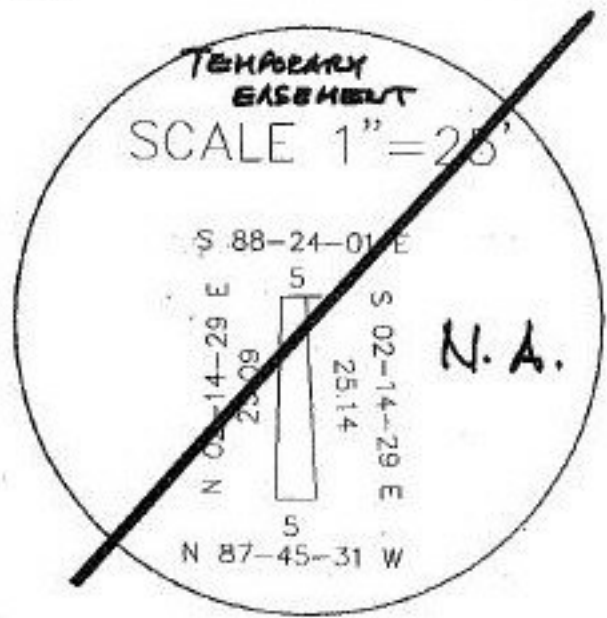


PARENT PARCEL: 03-00-006-504-001 3-00-016-504-003  
 CHILD PARCEL: NONE CREATED  
 STARTING POINT: CENTERLINE INTERSECTION ABBS RD & FRENCH CREEK RD

NO. 22252-D

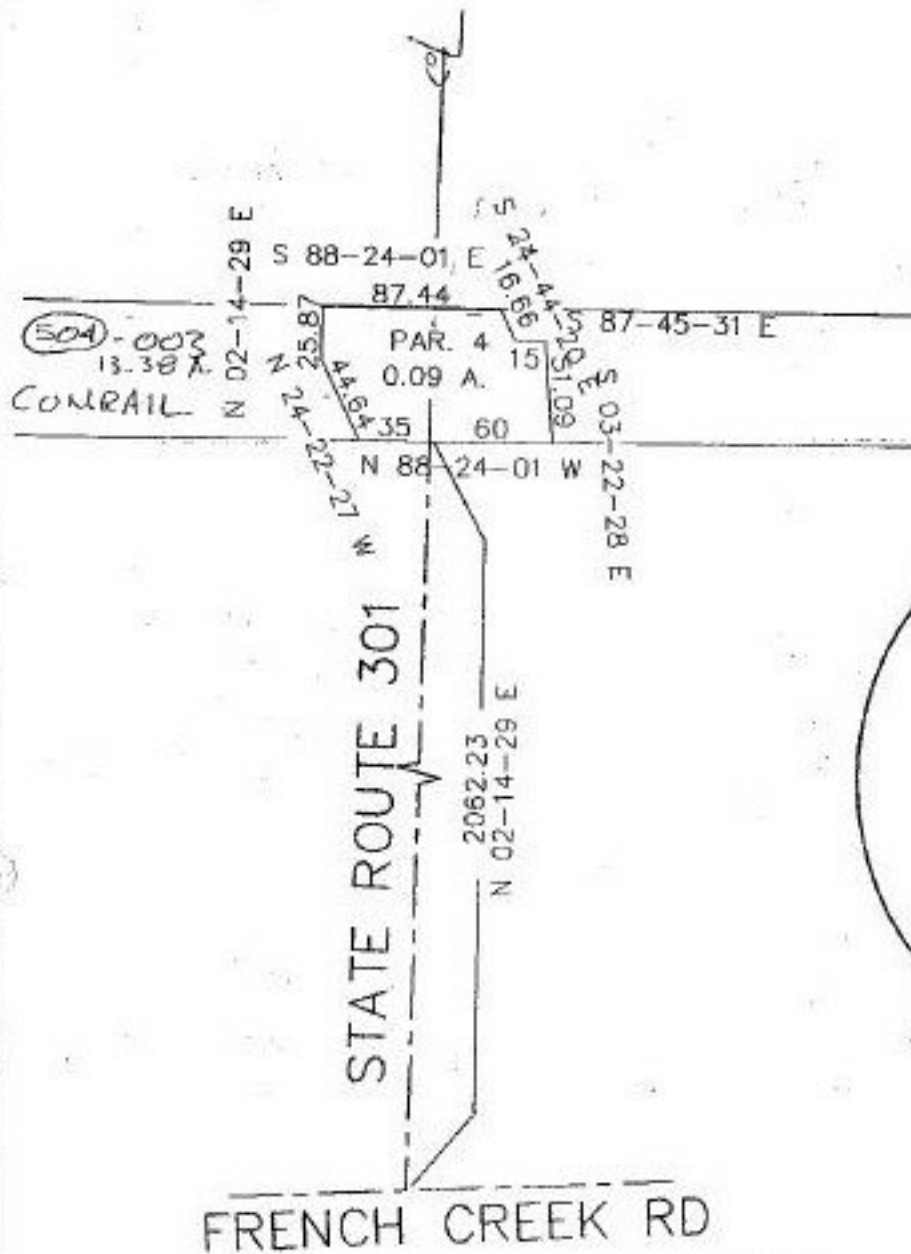

PAR. 3  
 0.003 A.  
 DOES NOT CLOSE  
 NOT ACCEPTABLE STARTING POINT

SURVEYED BY: COLOMBUS ENGINEERING CONSULTANTS, INC

SURVEYED BY: JAMES E. KENYON, ODOT  
 APRIL 1992  
 COLUMBUS ENGINEERING CONSULTANTS, INC  
 RICHARD D. HARRANG, P.S. 5002



**SPLITS/DEEDS PROCESSED**  
 LORAIN COUNTY TAX MAP DEPARTMENT  
 226 MIDDLE AVE. ELYRIA, OHIO

SURVEYED BY: COLUMBUS ENGR. CONSULTANTS RICHARD HARRANG #5002  
 CLOSURE: XXXXXX  
 MAP PAGE(S):  
 APPROVED BY: KAC DATE: 8/12/97  
 SCALE: 1"=100 PRIOR INSTRUMENT: