


#22252

NO. 22252

PARENT PARCEL: 04-00-029-000-061

CHILD PARCEL: 04-00-029-000-207, 208, 209

STARTING POINT: CL OF LEAR-NAGLE RD. & CL OF WALKER RD.

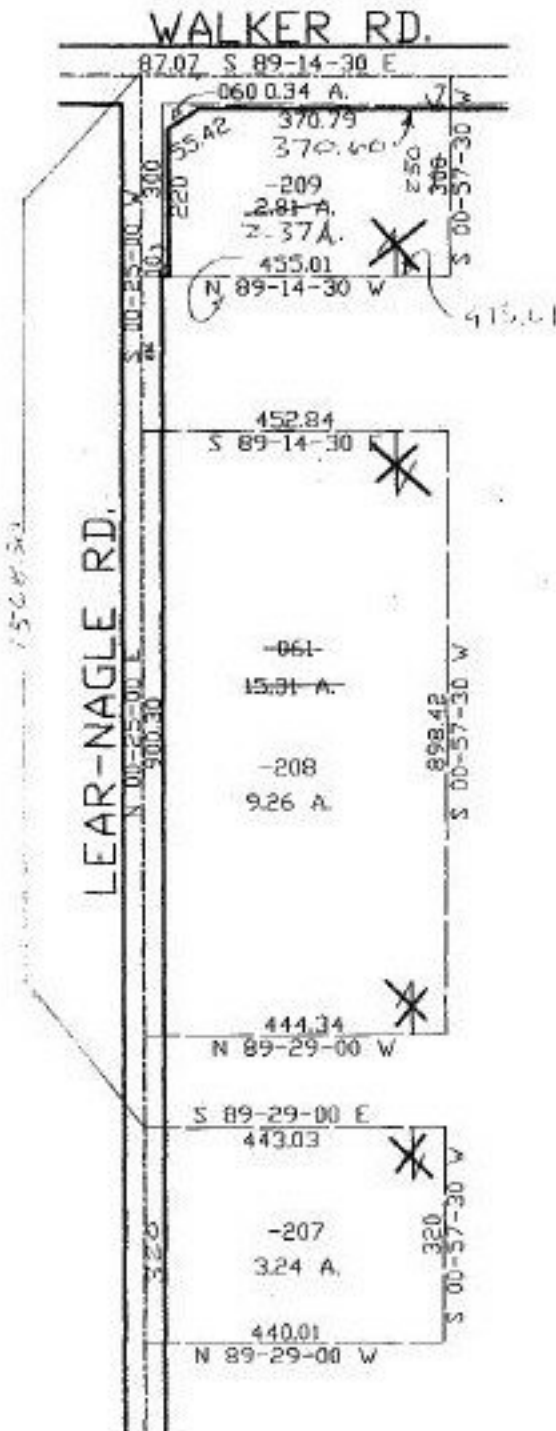

SPLITS/DEEDS PROCESSED
 LORAIN COUNTY TAX MAP DEPARTMENT
 226 MIDDLE AVE. ELYRIA, OHIO

SURVEYED BY: DONALD WOIKE
 CLOSURE: 0.07 PER 10,000
 MAP PAGE(S): 04-0
 APPROVED BY: KAC DATE: 7/30/97
 SCALE: 1" = 300'