


PARENT PARCEL: 08-00-091-000-019

CHILD PARCEL: 09-00-091-000-055, -056

STARTING POINT: CL OF MILAN-ELYRIA RD. & CL OF GIFFORD RD.

NO. 22253

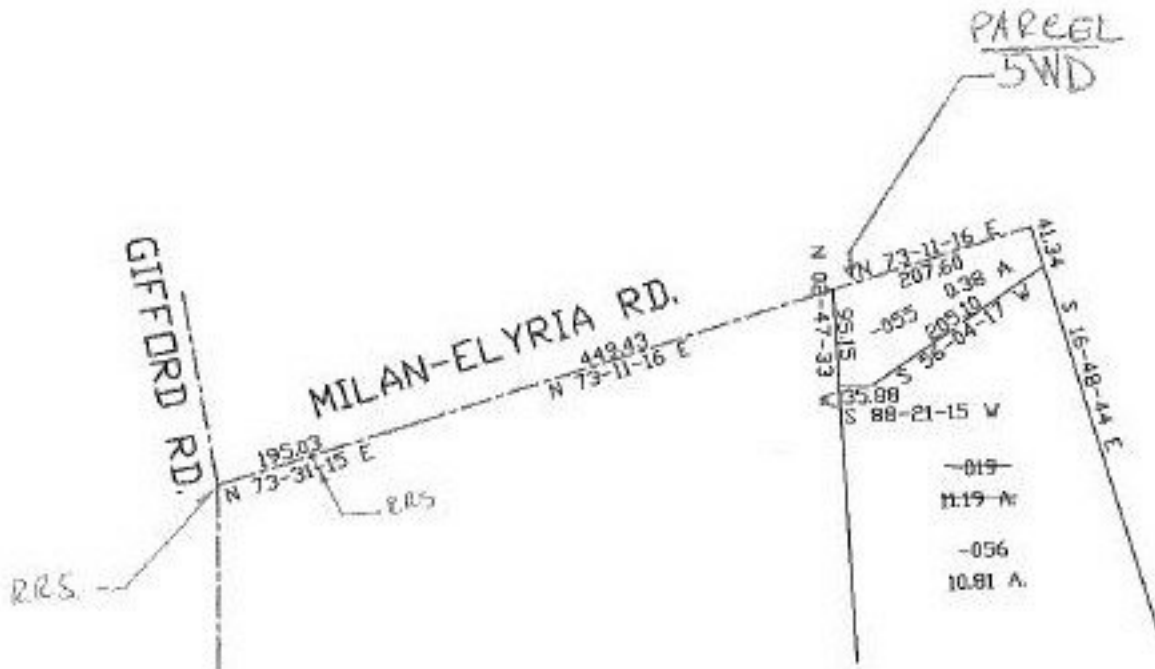

TS
2-17-98



SPLITS/DEEDS PROCESSED
LORAIN COUNTY TAX MAP DEPARTMENT
226 MIDDLE AVE. ELYRIA, OHIO

SURVEYED BY: Ronald Robinson PS# 56857
 CLOSURE: 0.54:10.000
 MAP PAGE(S): 8-C
 APPROVED BY: KAC DATE: 8/12/97
 SCALE: 1" = 200 PRIOR INSTRUMENT: OR 1152/584