


#22258

#22258

APPROVED
LORAIN CO.
MAP DEPT.
DATE 8-25-97
FIG. 4-00-002-B
T. M. M. M.
22258

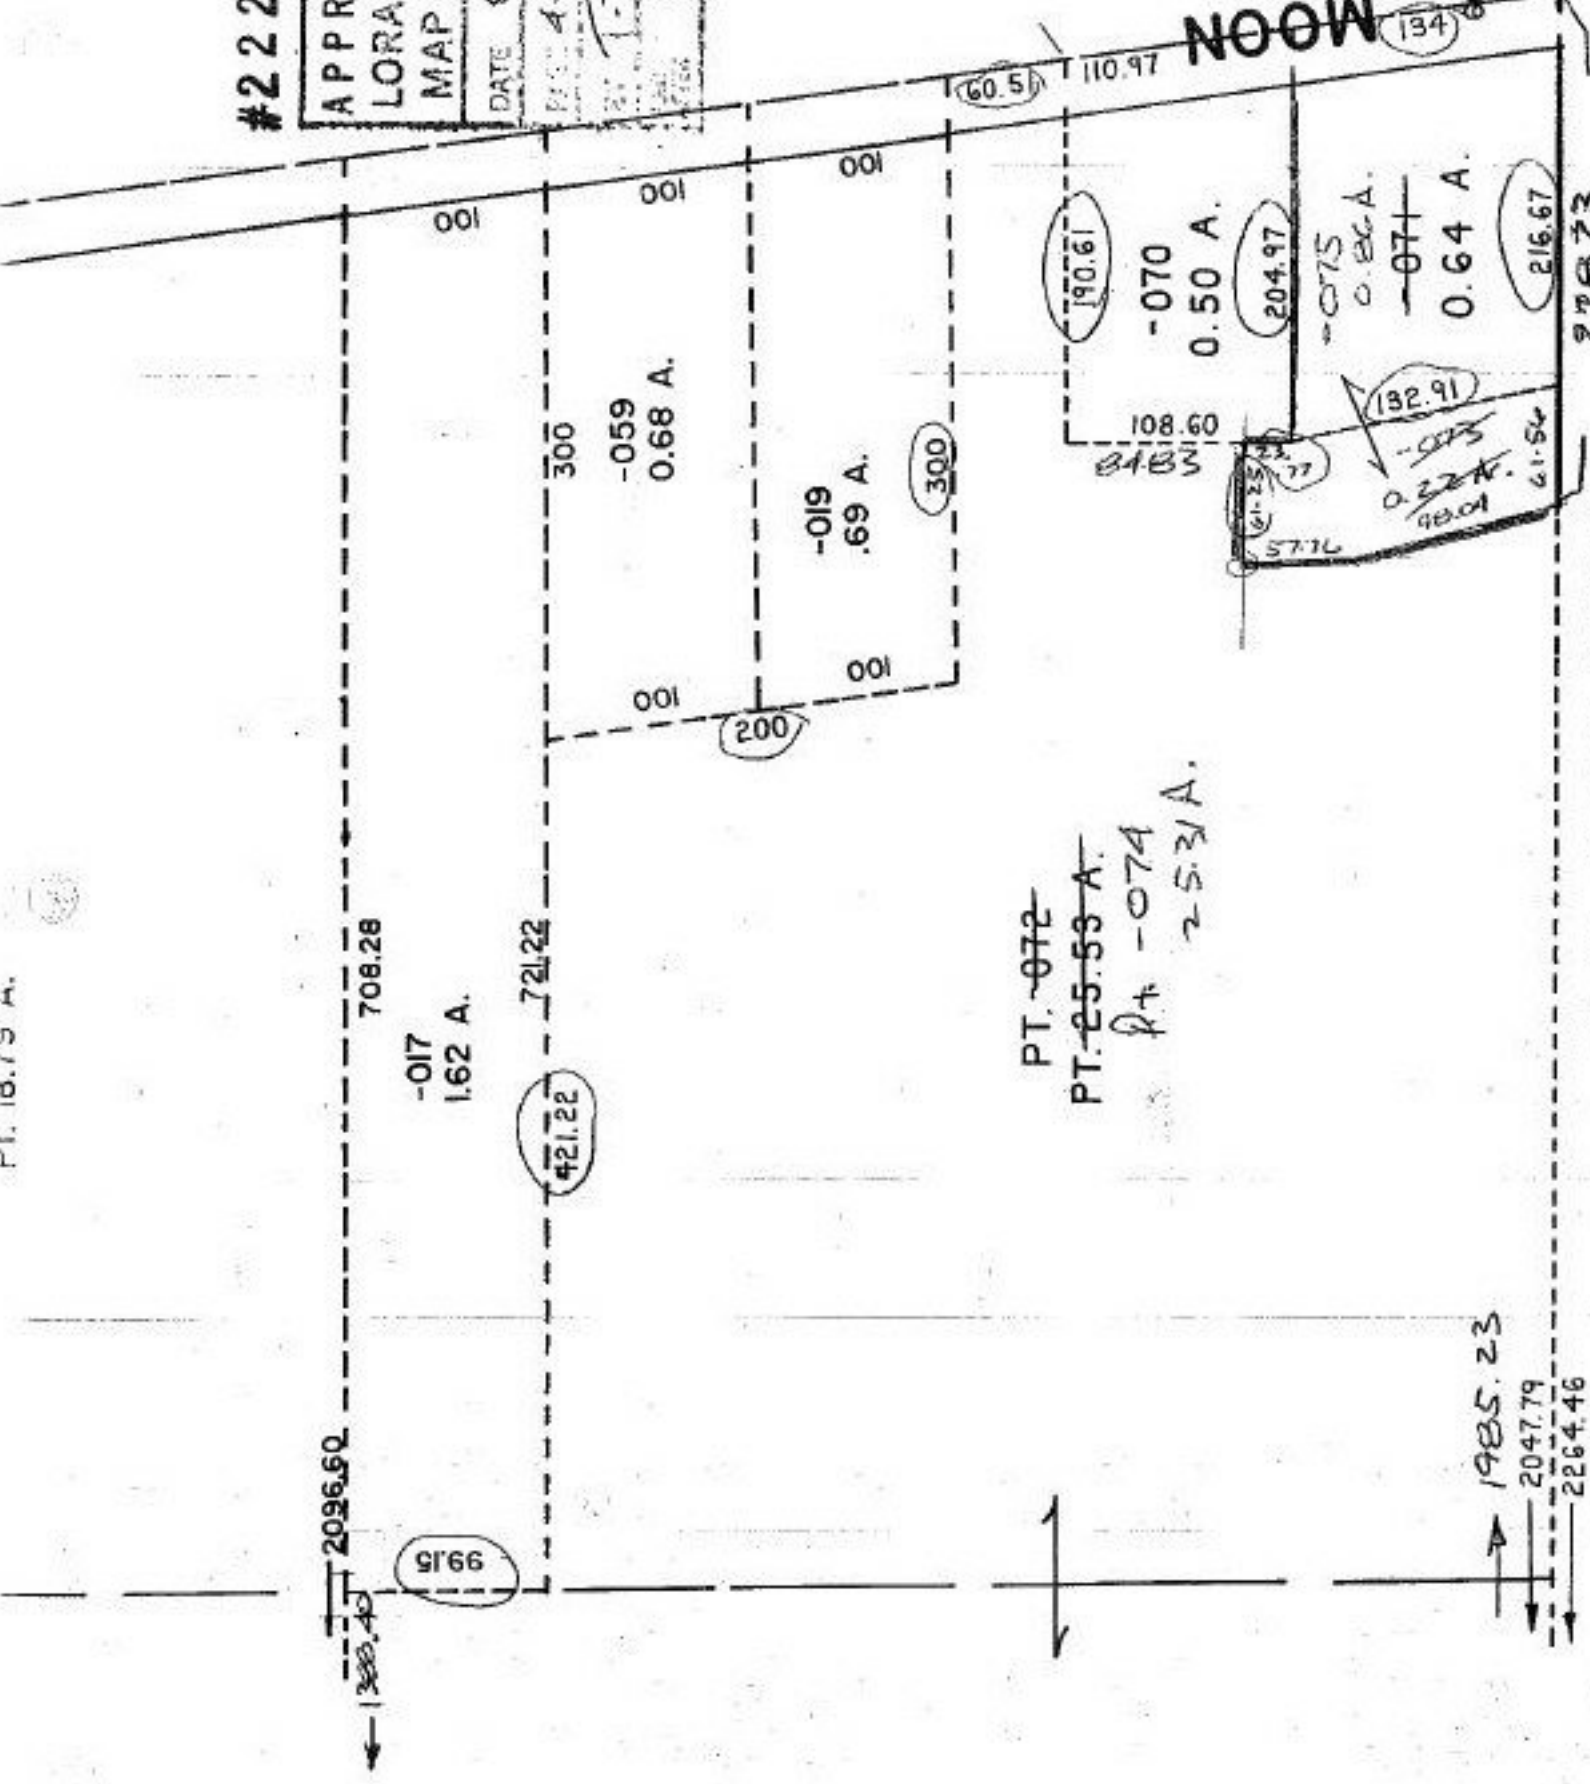

PT. ~~072~~
 PT. ~~25.53 A.~~
 Pt ~~074~~
 2.53 A.

SEE 4-00-002-F