

PARENT PARCEL: 07-00-022-101-080

CHILD PARCEL: 07-00-022-101-083, 084


STARTING POINT: cl. of Westwood Dr. & cl. of Avon Belden Rd.

NO. 22259



Westwood Dr.

Avon Belden Rd.

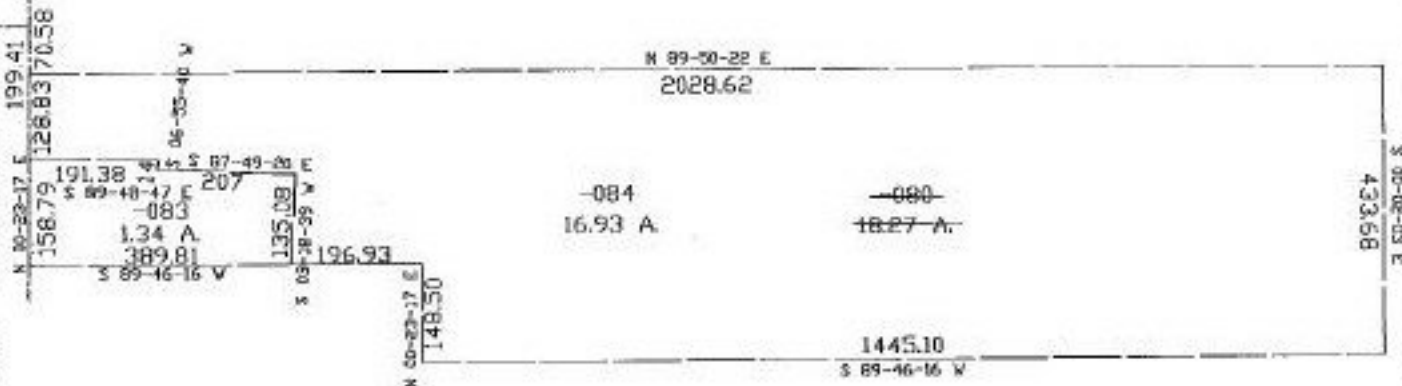

TS
5-5-98



SPLITS/DEEDS PROCESSED
 LORAIN COUNTY TAX MAP DEPARTMENT
 226 MIDDLE AVE. ELYRIA, OHIO

SURVEYED BY: John Pozynak
 CLOSURE: 0.15 : 10,000
 MAP PAGE(S): 7-00-022-C, D
 APPROVED BY: KAC DATE: 8/26/97
 SCALE: 1" = 300' PRIOR INSTRUMENT: or 54/178