


#22261
NO. 22261

PARENT PARCEL: 01-00-050-000-027

CHILD PARCEL: 01-050-000-039, 040, 041, 042

STARTING POINT: CL OF GORE ORPHANGE RD. & NORTH RIDGE RD.

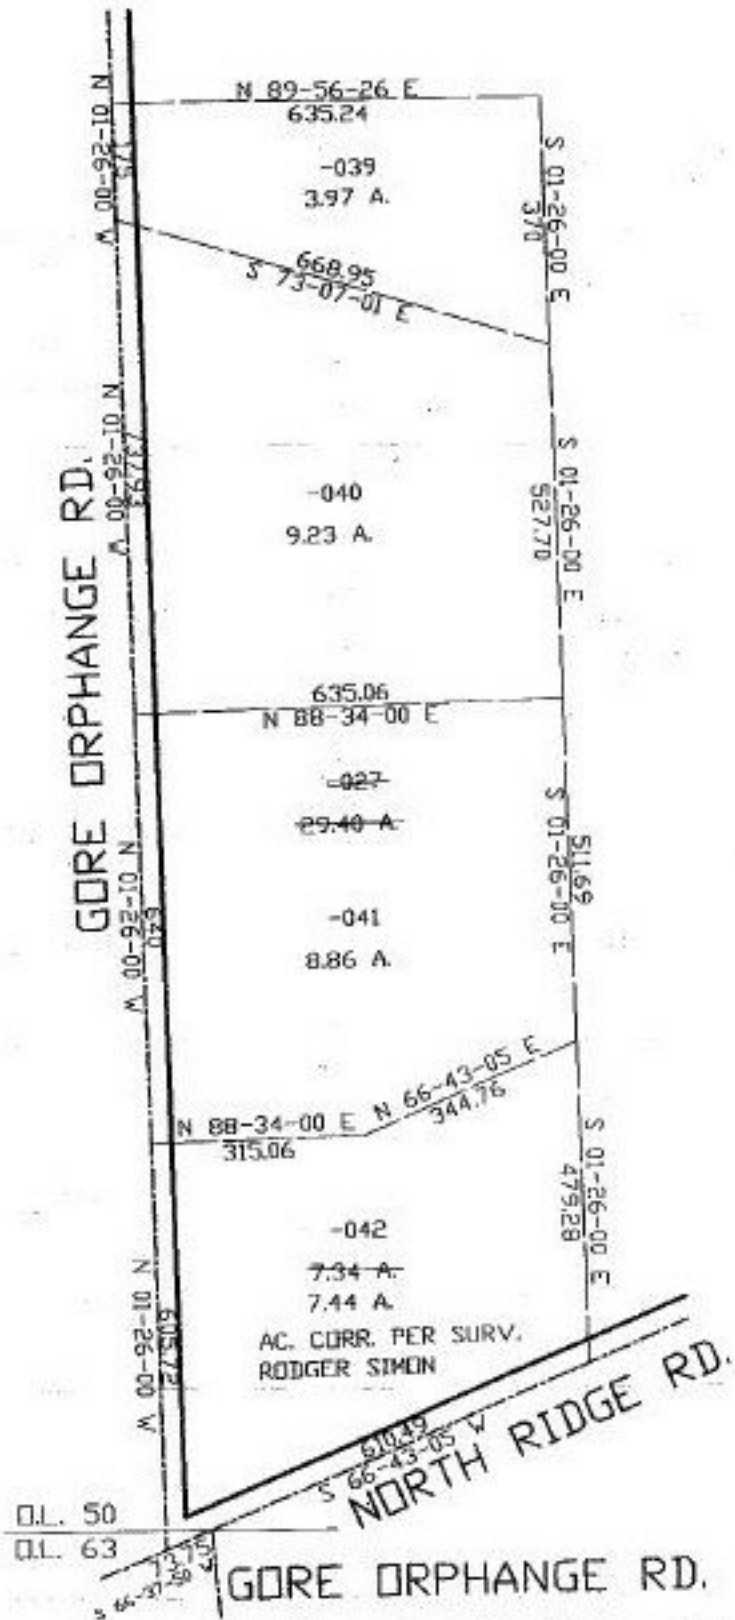

SPLITS/DEEDS PROCESSED
LORAIN COUNTY TAX MAP DEPARTMENT
226 MIDDLE AVE. ELYRIA, OHIO

SURVEYED BY: RODGER G. SIMON
CLOSURE: 0.03:10.000
MAP PAGE(S): 01-1
APPROVED BY: MJC DATE: 7/31/97
SCALE: 1" = 300'