

#22262

NO. 22262

PARENT PARCEL: 04-00-024-101-154


CHILD PARCEL: 04-00-024-101-156 THRU -160

STARTING POINT: NW CORNER O.L. 24 (ALSO, CL OF RIEGELSBERGER RD)



RIEGELSBERGER RD.

S 89-41-00 E

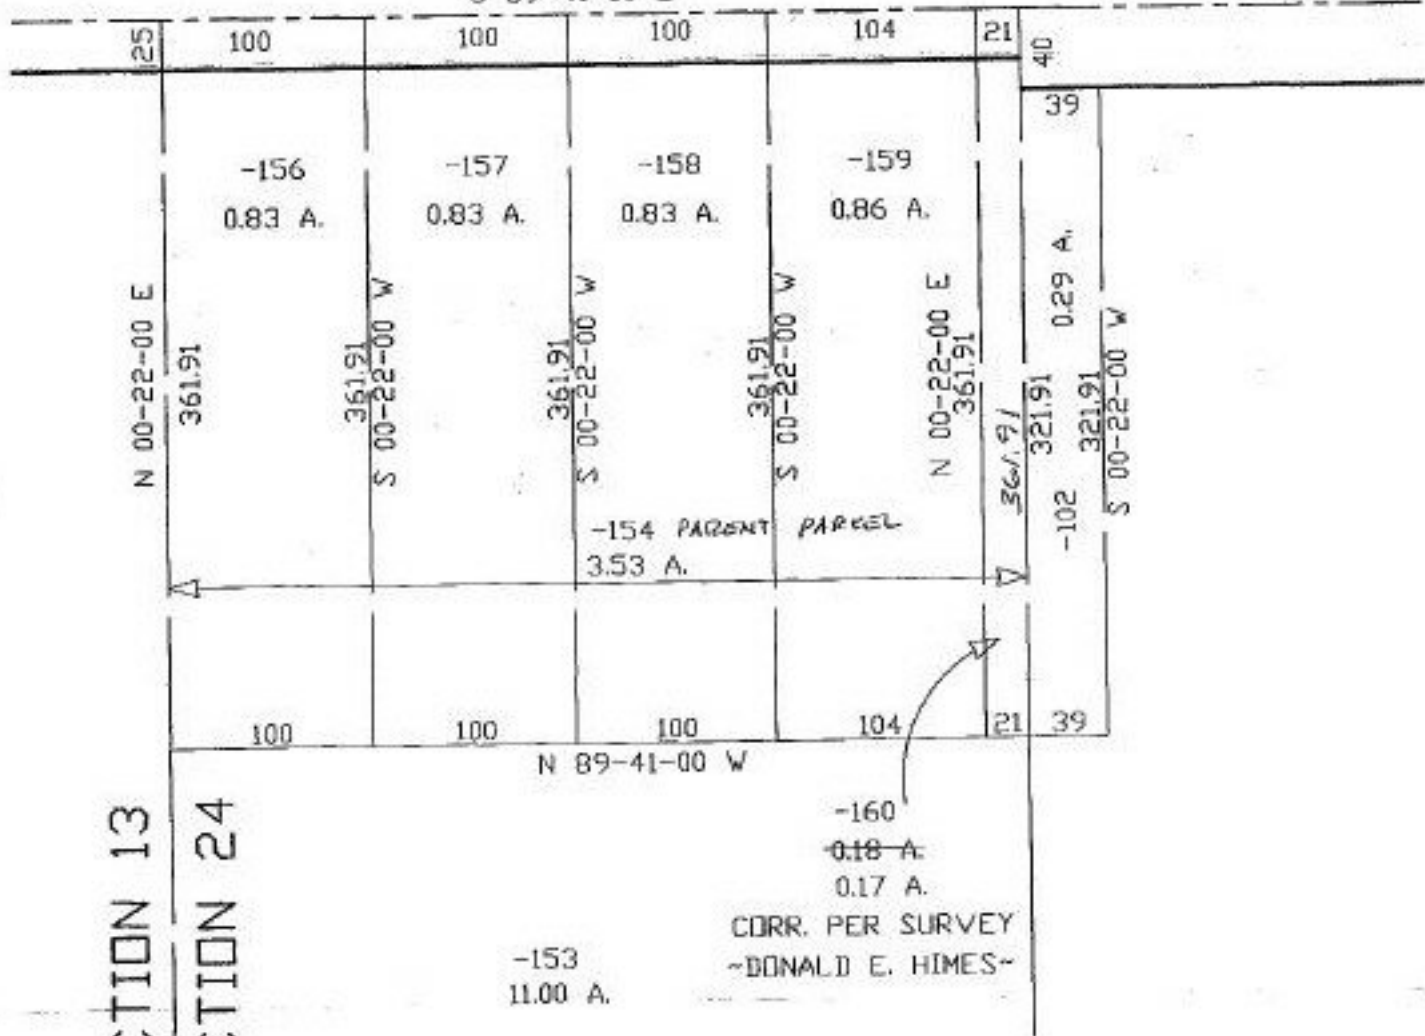

SPLITS/DEEDS PROCESSED
 LORAIN COUNTY TAX MAP DEPARTMENT
 226 MIDDLE AVE. ELYRIA, OHIO

SURVEYED BY: DONALD E. HIMES
 CLOSURE: 0.00:10.000
 MAP PAGE(S): 04-00-024-A
 APPROVED BY: KAC DATE: 8/6/97
 SCALE: 1" = 100' PRIOR INST: 1449/387