


PARENT PARCEL: 07-00-031-000-044

CHILD PARCEL: 07-00-031-000-058, 059, 060

STARTING POINT: c.l. of Stoney Ridge Rd. & c.l. of Borres Rd.

NO. 22263

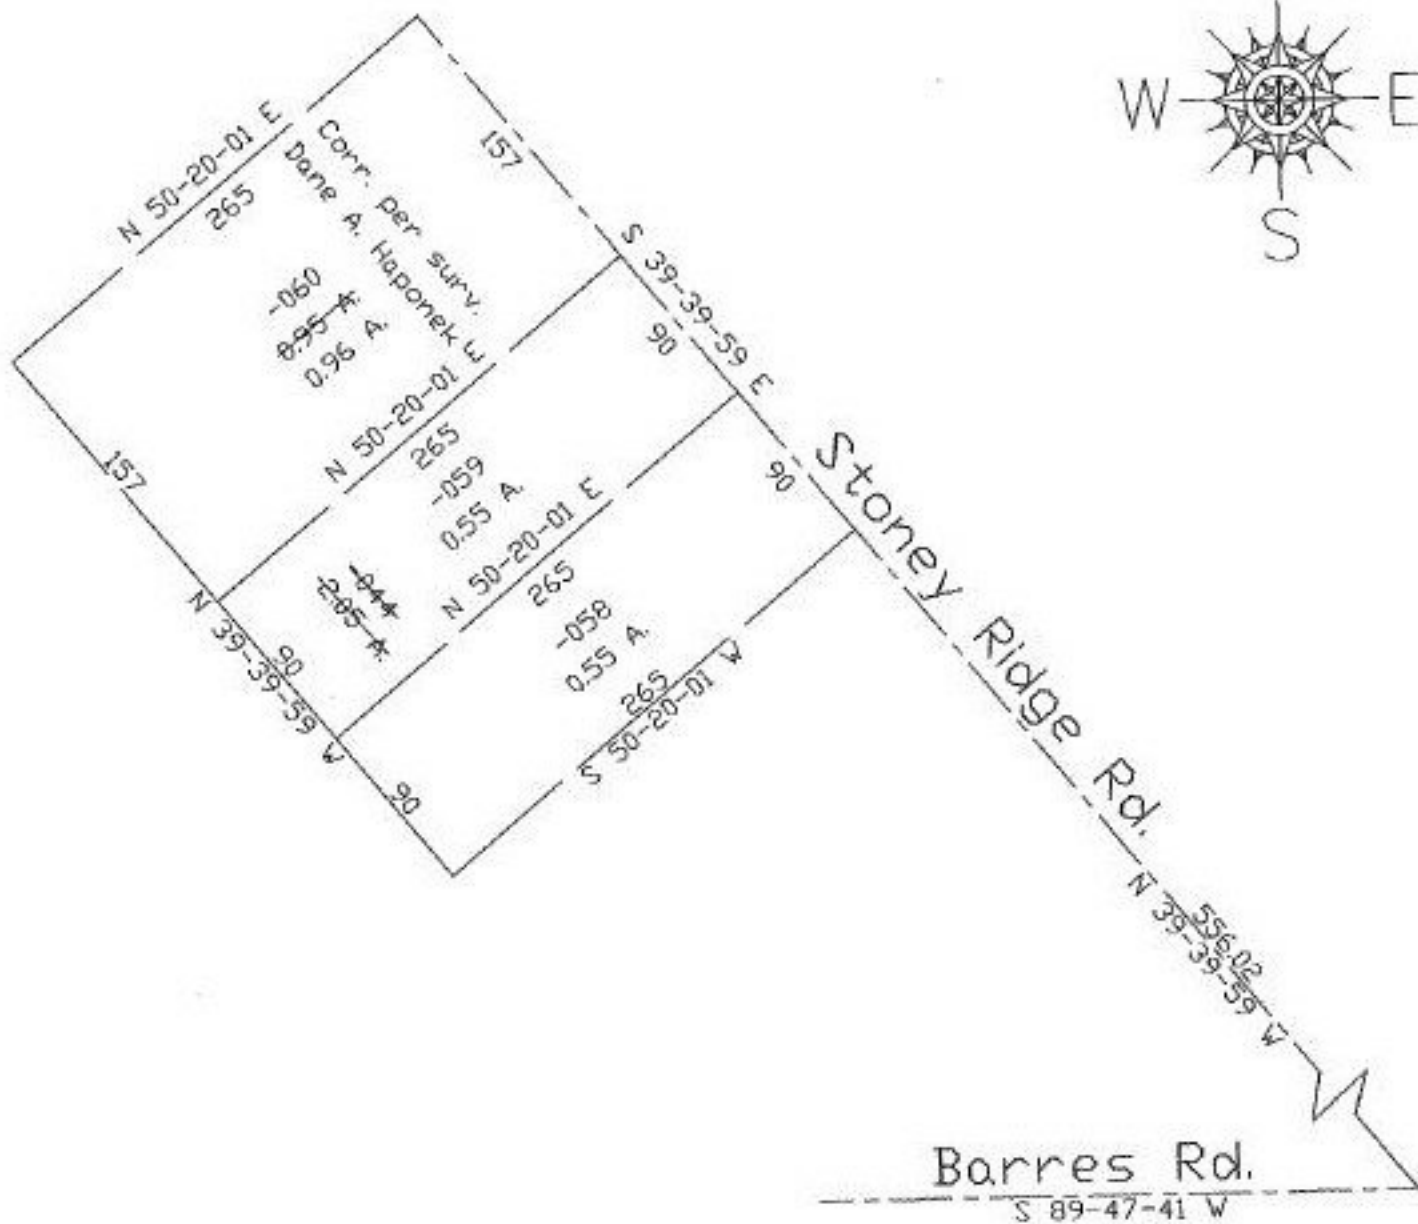

JH. 10/12/98

SPLITS/DEEDS PROCESSED

LORAIN COUNTY TAX MAP DEPARTMENT
226 MIDDLE AVE. ELYRIA, OHIO

SURVEYED BY: Done A. Hapanek

CLOSURE: 0.00 per 10,000

MAP PAGE(S): 07-8

APPROVED BY: kac DATE: 8/18/97

SCALE: 1" = 100' PRIOR INSTRUMENT: 1382/426