


84.51 A. 06 23
 28.58 A. 06 22

 113.09

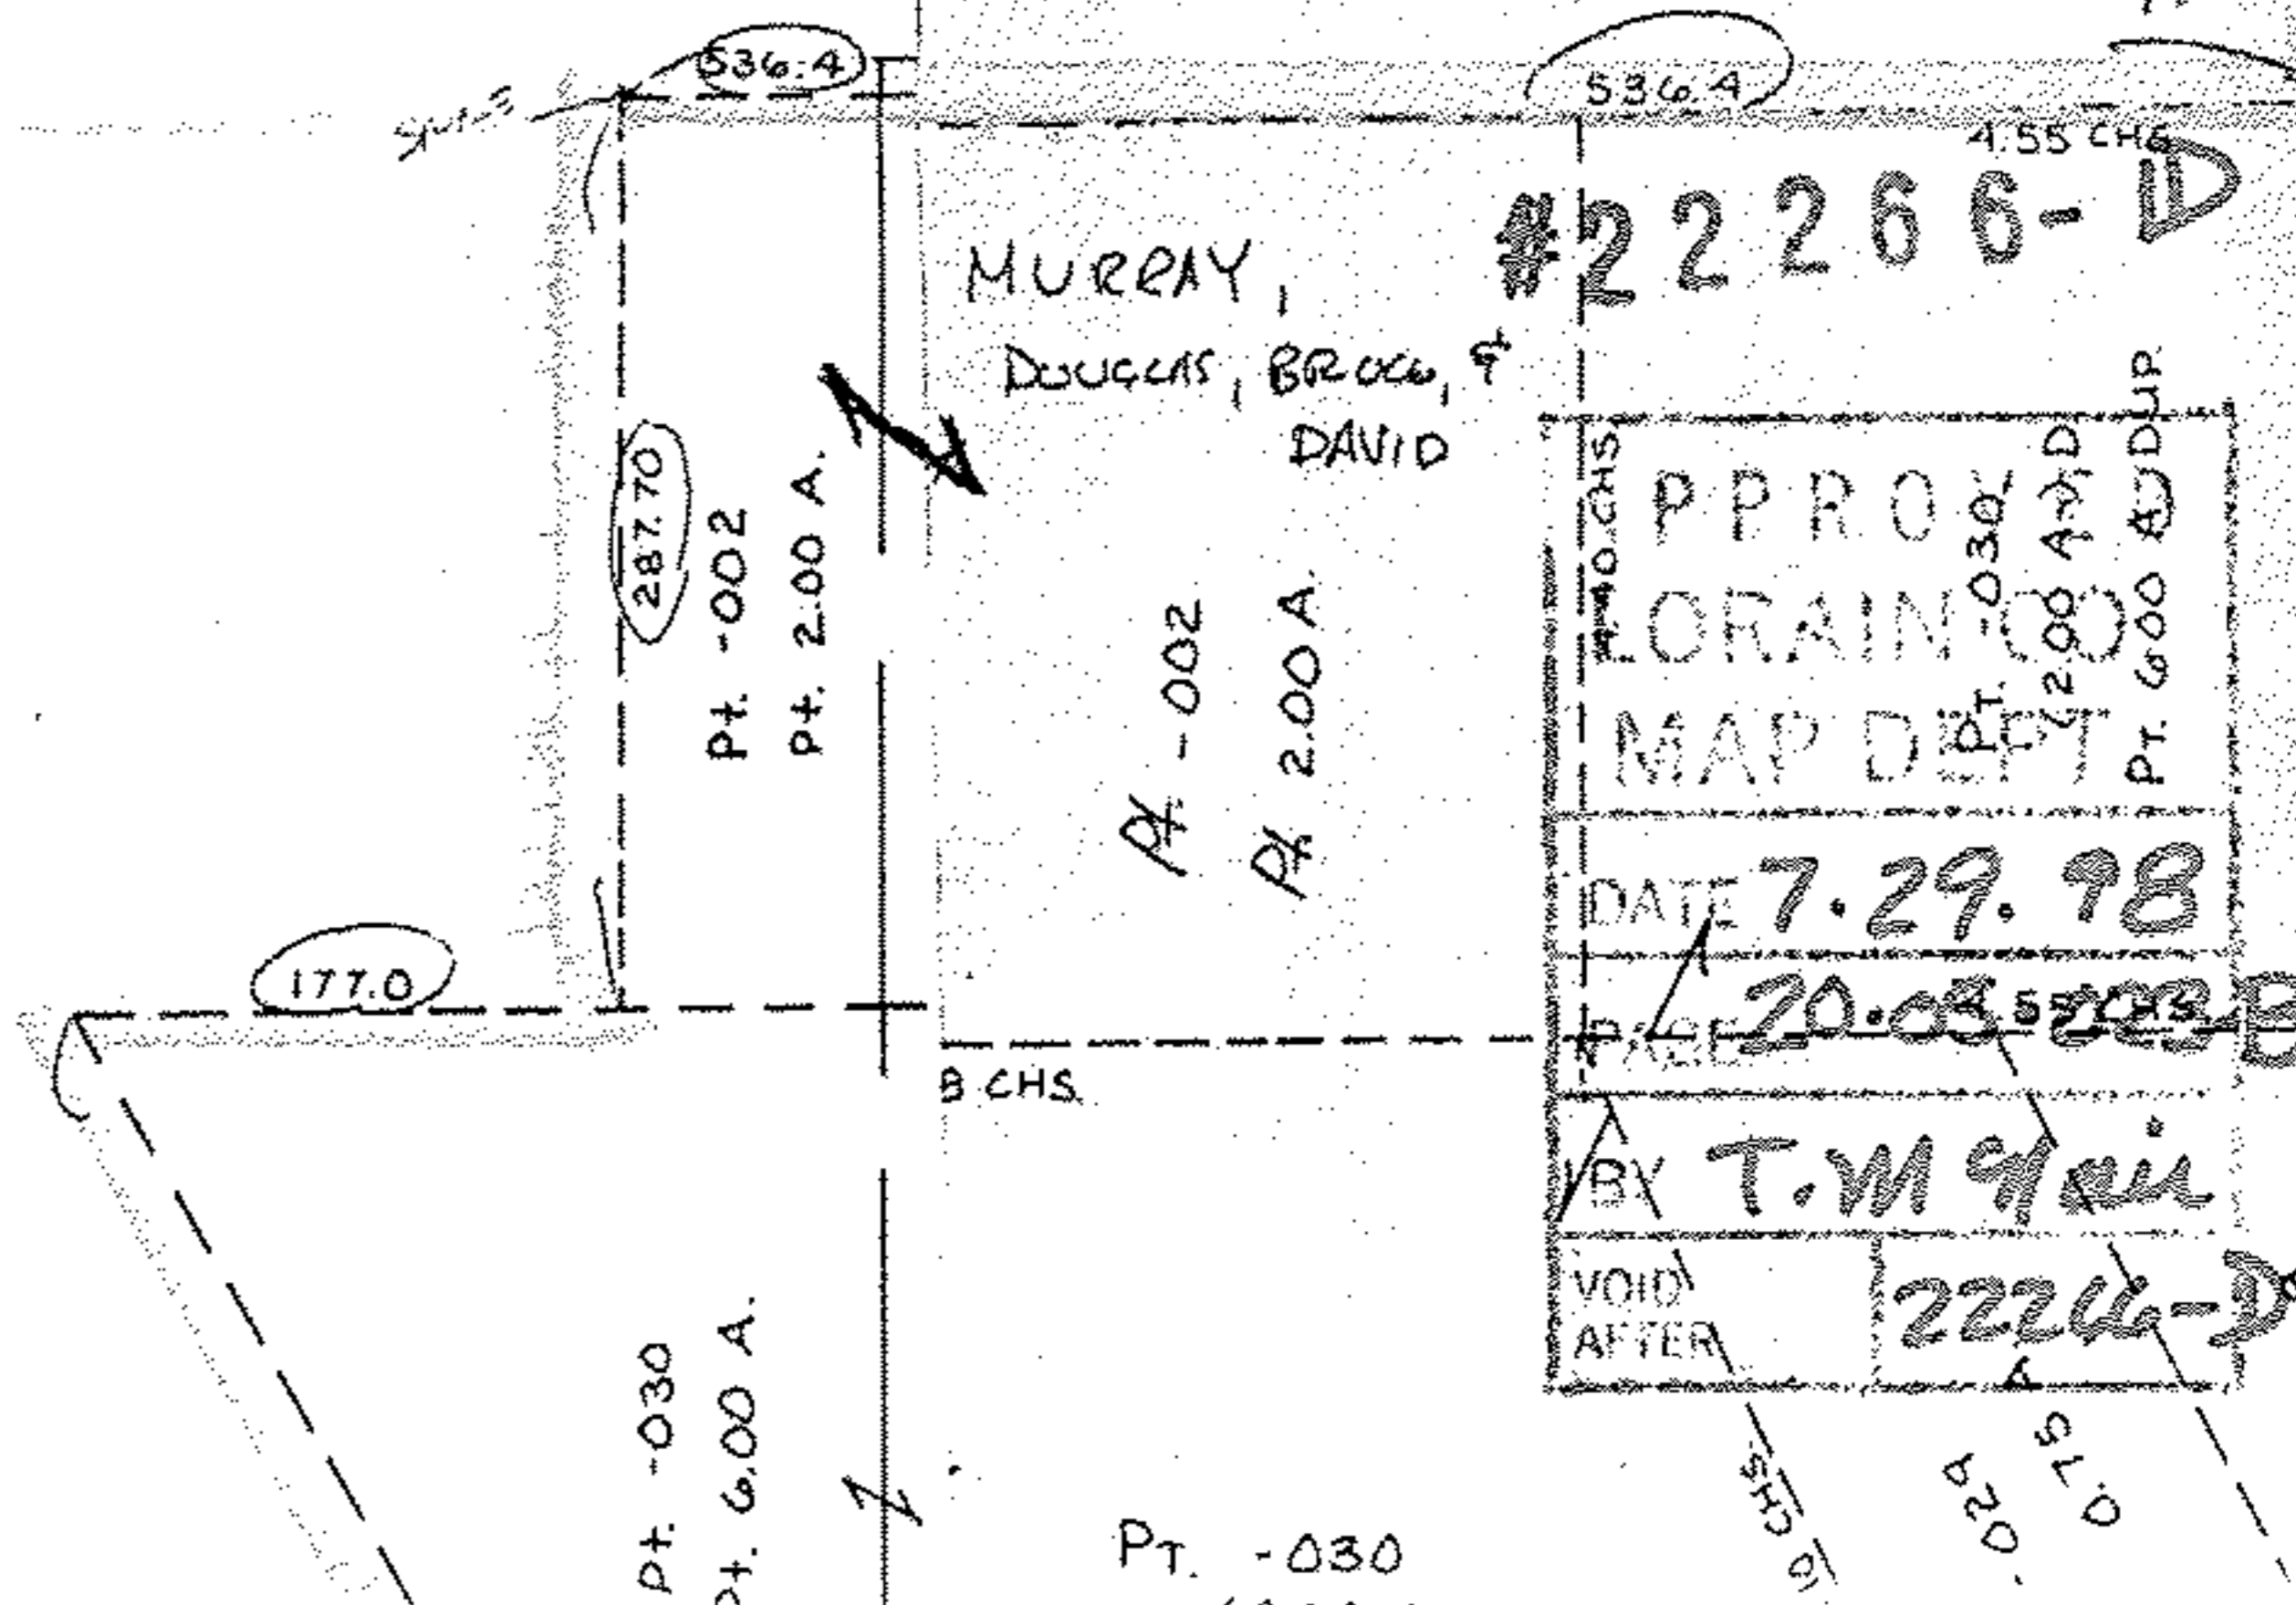

PT -035
RESERVED

101

MURRAY,
DUNCAN, BRUCE, &
DAVID

#22266-D

PROX	0.30	ADD
ORAIN	0.00	ADD
MAP DEPT	2.00	ADD
DATE	7.29.98	
BY	T.M. GRIFFIN	
VOID AFTER	22266-D	

0.75
0.29