


#22268

NO. 22268

PARENT PARCEL: 11-00-098-000-037

CHILD PARCEL: 11-00-098-000-065, 066

STARTING POINT: cl. of Elyria-Grafton Rd. & north line of Eaton Twp. Rd.

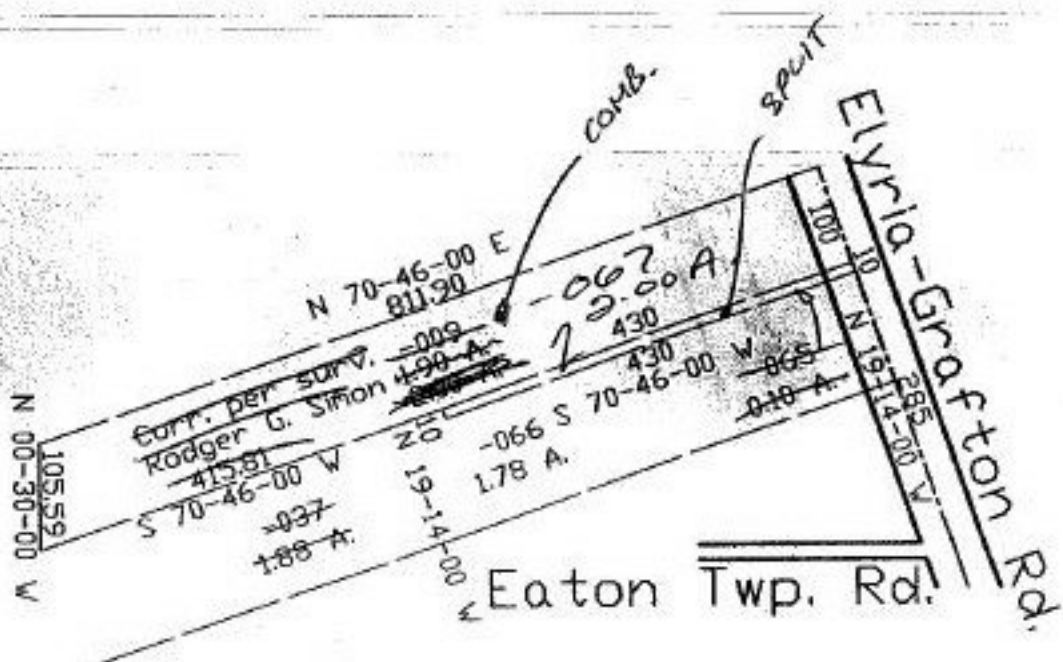

SPLITS/DEEDS PROCESSED
 LORAIN COUNTY TAX MAP DEPARTMENT
 226 MIDDLE AVE. ELYRIA, OHIO

SURVEYED BY: Rodger G. Simon
 CLOSURE: 0.02 per 10,000
 MAP PAGE(S): 11-00-098-A
 APPROVED BY: kac DATE: 8/19/97
 SCALE: 1" = 200' PRIOR INSTRUMENT: