


#22270

PARENT PARCEL: 04-00-016-101-046

CHILD PARCEL: 04-00-016-101-072-073

STARTING POINT: cl. of Avon Center Rd. & cl. of Chester Rd.

NO. 22270

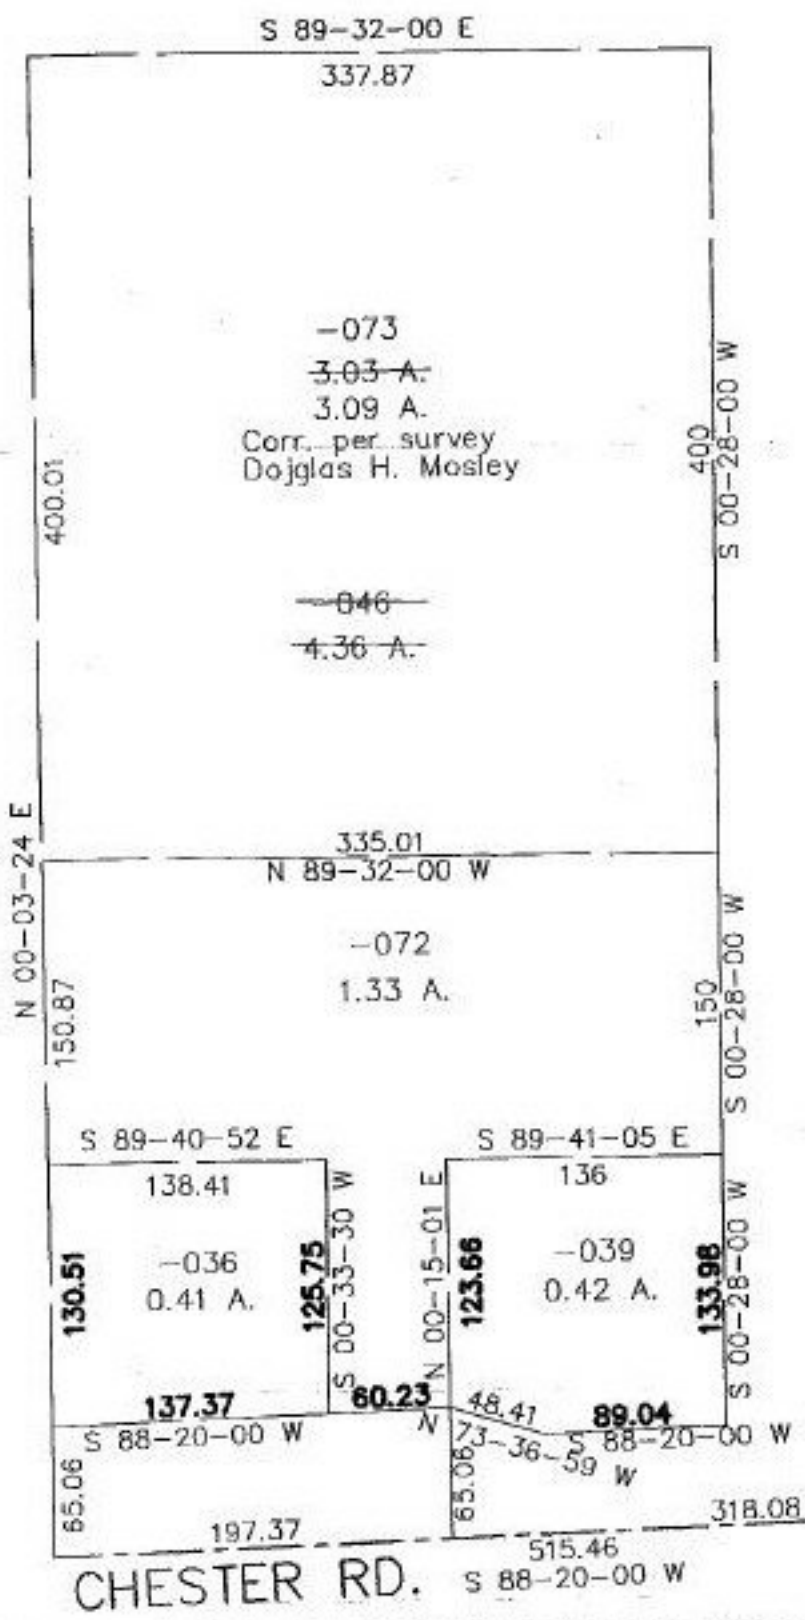

RED DISTANCES NEED TO BE FIXED ON OUR TAX MAP.



SPLITS/DEEDS PROCESSED
 LORAIN COUNTY TAX MAP DEPARTMENT
 226 MIDDLE AVE. ELYRIA, OHIO

SURVEYED BY: Douglas H. Mosley
 CLOSURE: 0.00 per 10.000
 MAP PAGE(S): 04-00-016-F
 APPROVED BY: kac DATE: 8/15/97
 SCALE: 1" = 100' PRIOR INSTRUMENT: OR 1221-155