


#22272

NO. 22272

PARENT PARCEL: 05-00-055-000-007, 011.

CHILD PARCEL: 05-00-055-000-030, 031

STARTING POINT: cl. of Ohio Turnpike & cl. of Oberlin Rd.

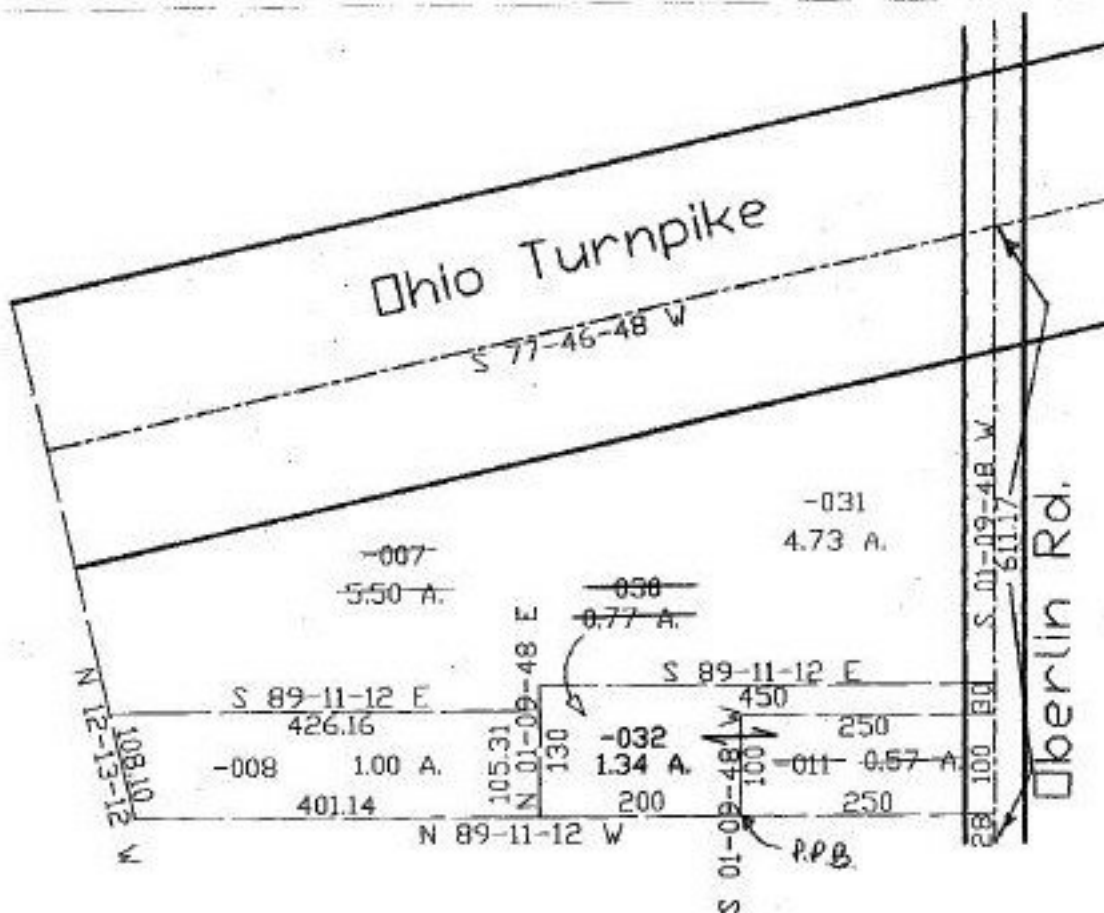

SPLITS/DEEDS PROCESSED

LORAIN COUNTY TAX MAP DEPARTMENT
226 MIDDLE AVE. ELYRIA, OHIO

SURVEYED BY: Rodger G. Simon

CLOSURE: 0.00-10.000

MAP PAGE(S): 5-6

APPROVED BY: KAC DATE: 8/26/97

SCALE: 1" = 200. PRIOR INSTRUMENT: