


#22273-X

SEE 3-00-

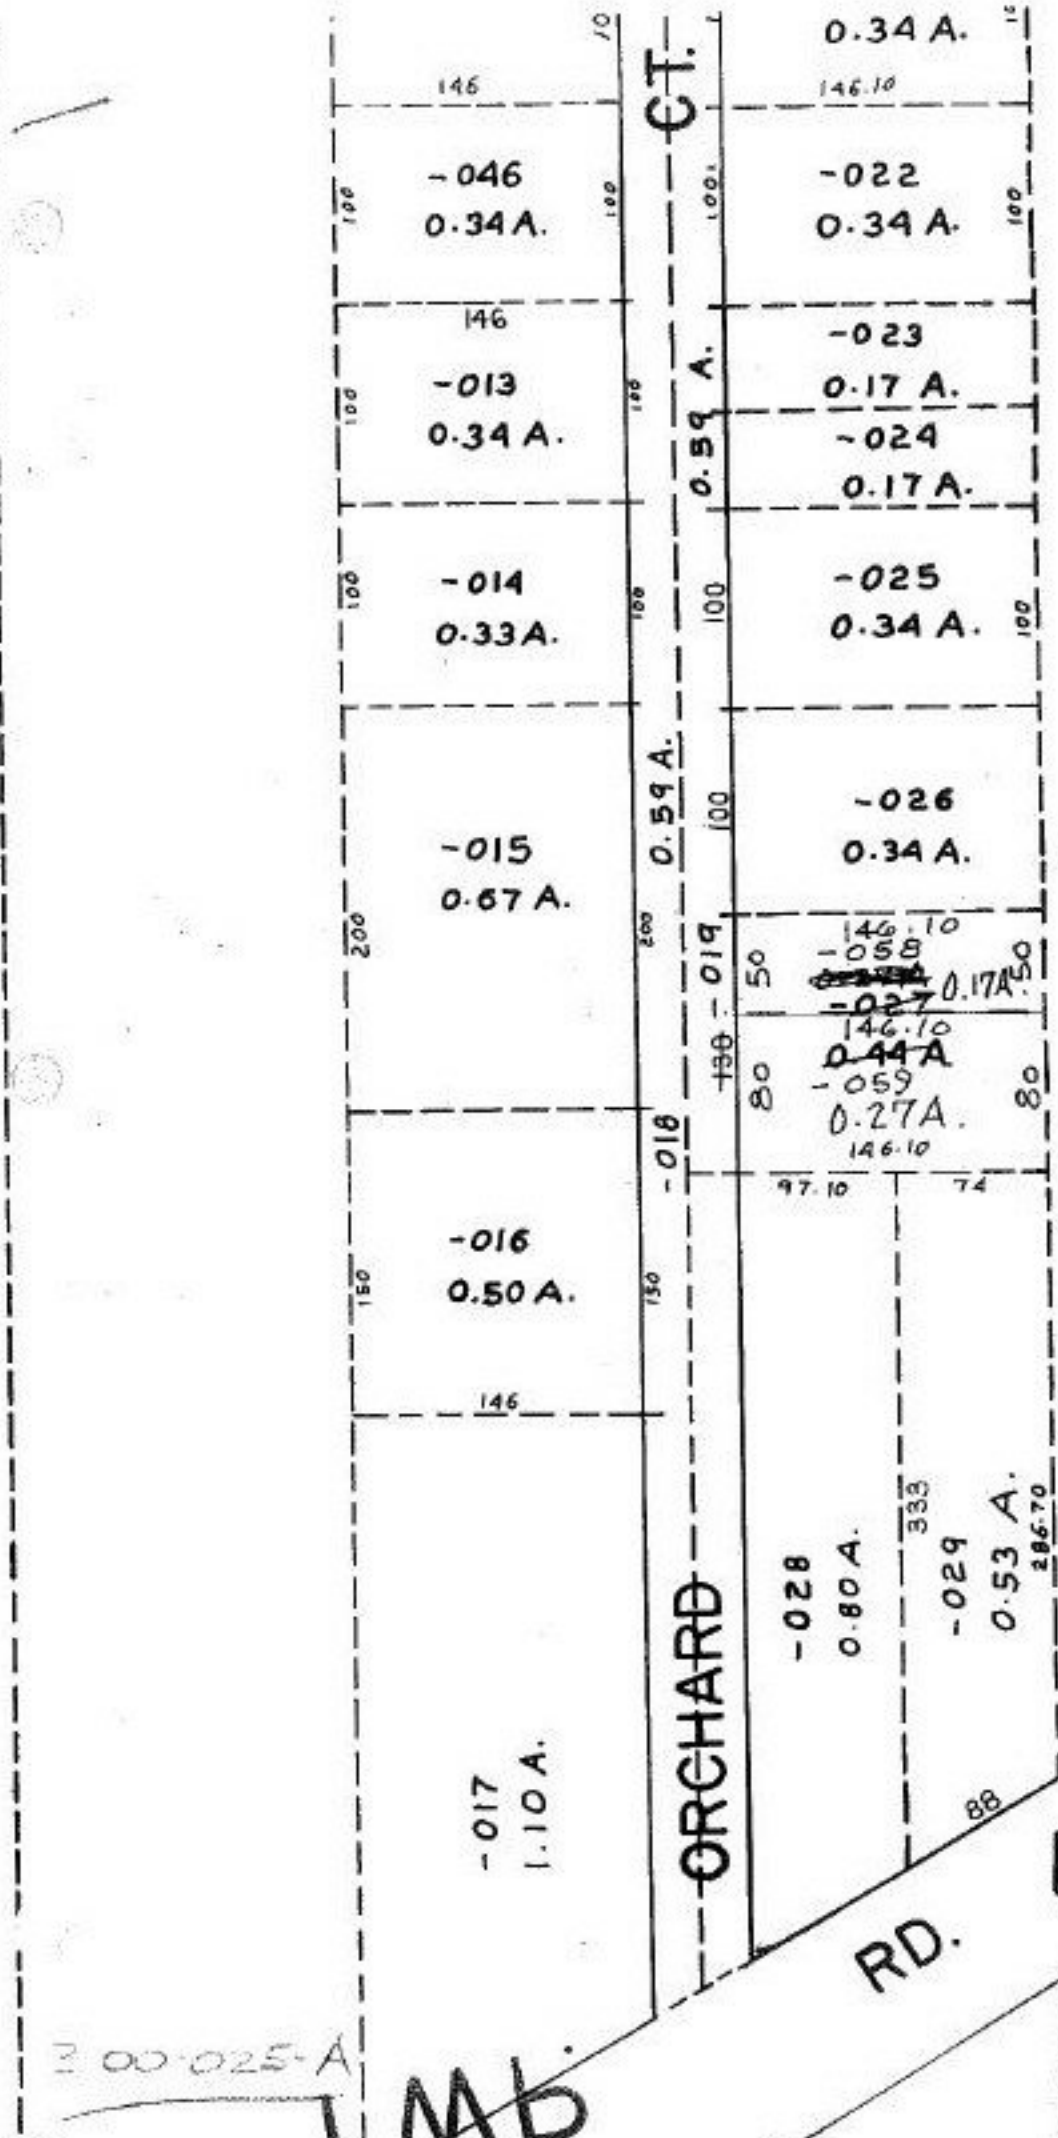

SEE DEEDS  
 Vou.  
 408  
 415  
 OR 250

Pg.  
 182  
 430  
 805

#22273X

APPROVED LORAIN CO. MAP DEPT.	
DATE 8-7-97	
PAGE 3-00-025-A	
BY <i>J. Collett</i>	
VOID AFTER	22273X