


#22274

NO. 22274

PARENT PARCEL: 01-00-031-000-061

CHILD PARCEL: 01-00-031-000-062, 063

STARTING POINT: c.l. of Vermilion Rd. & c.l. of Jerusalem Rd.

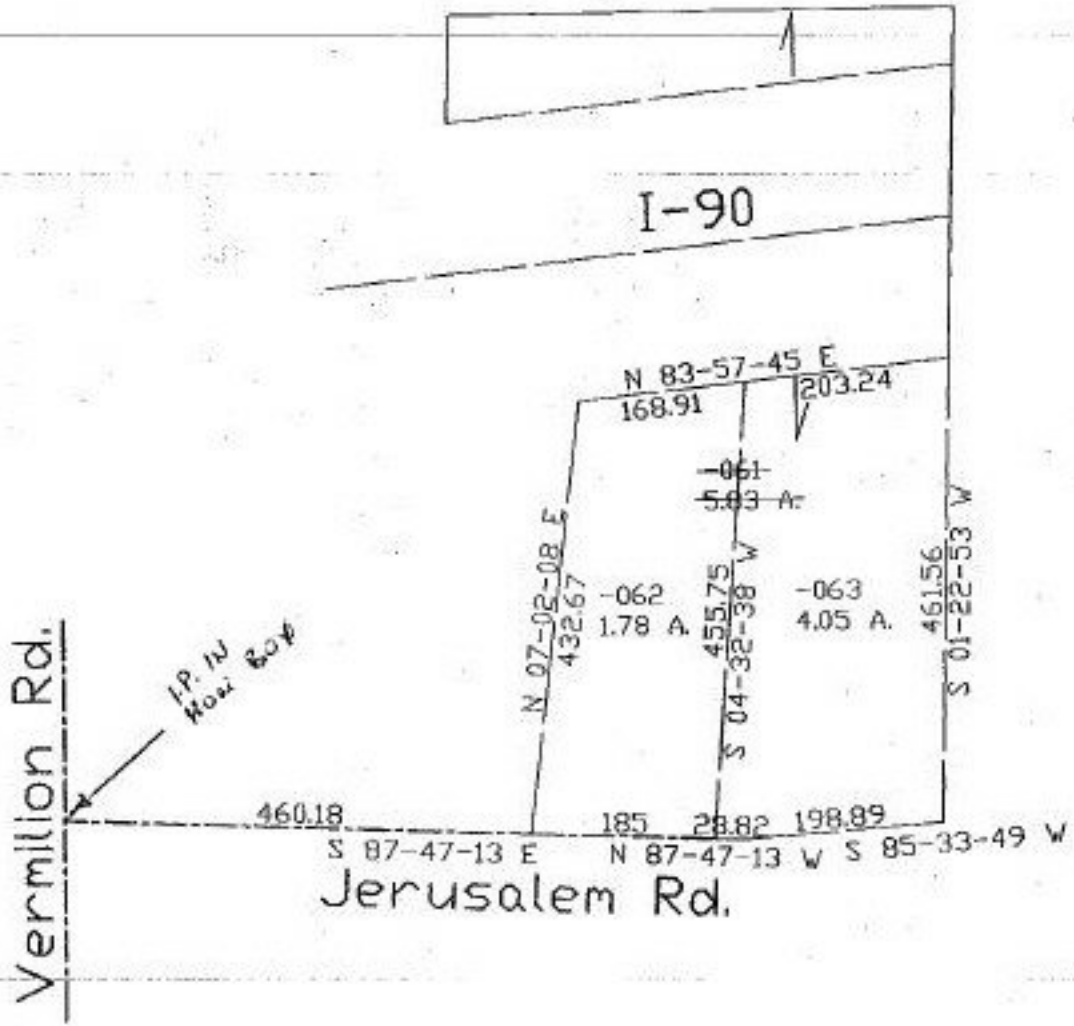

**SPLITS/DEEDS PROCESSED**  
 LORAIN COUNTY TAX MAP DEPARTMENT  
 226 MIDDLE AVE. ELYRIA, OHIO

SURVEYED BY: Earl H. Hunter  
 CLOSURE: 0.04:10,000  
 MAP PAGE(S): 01-00-031-B  
 APPROVED BY: kac DATE: 9/9/97  
 SCALE: 1" = 200' PRIOR INSTRUMENT: OR 535/356