


SEE 2-

Pt. -02  
Pt. 7.95

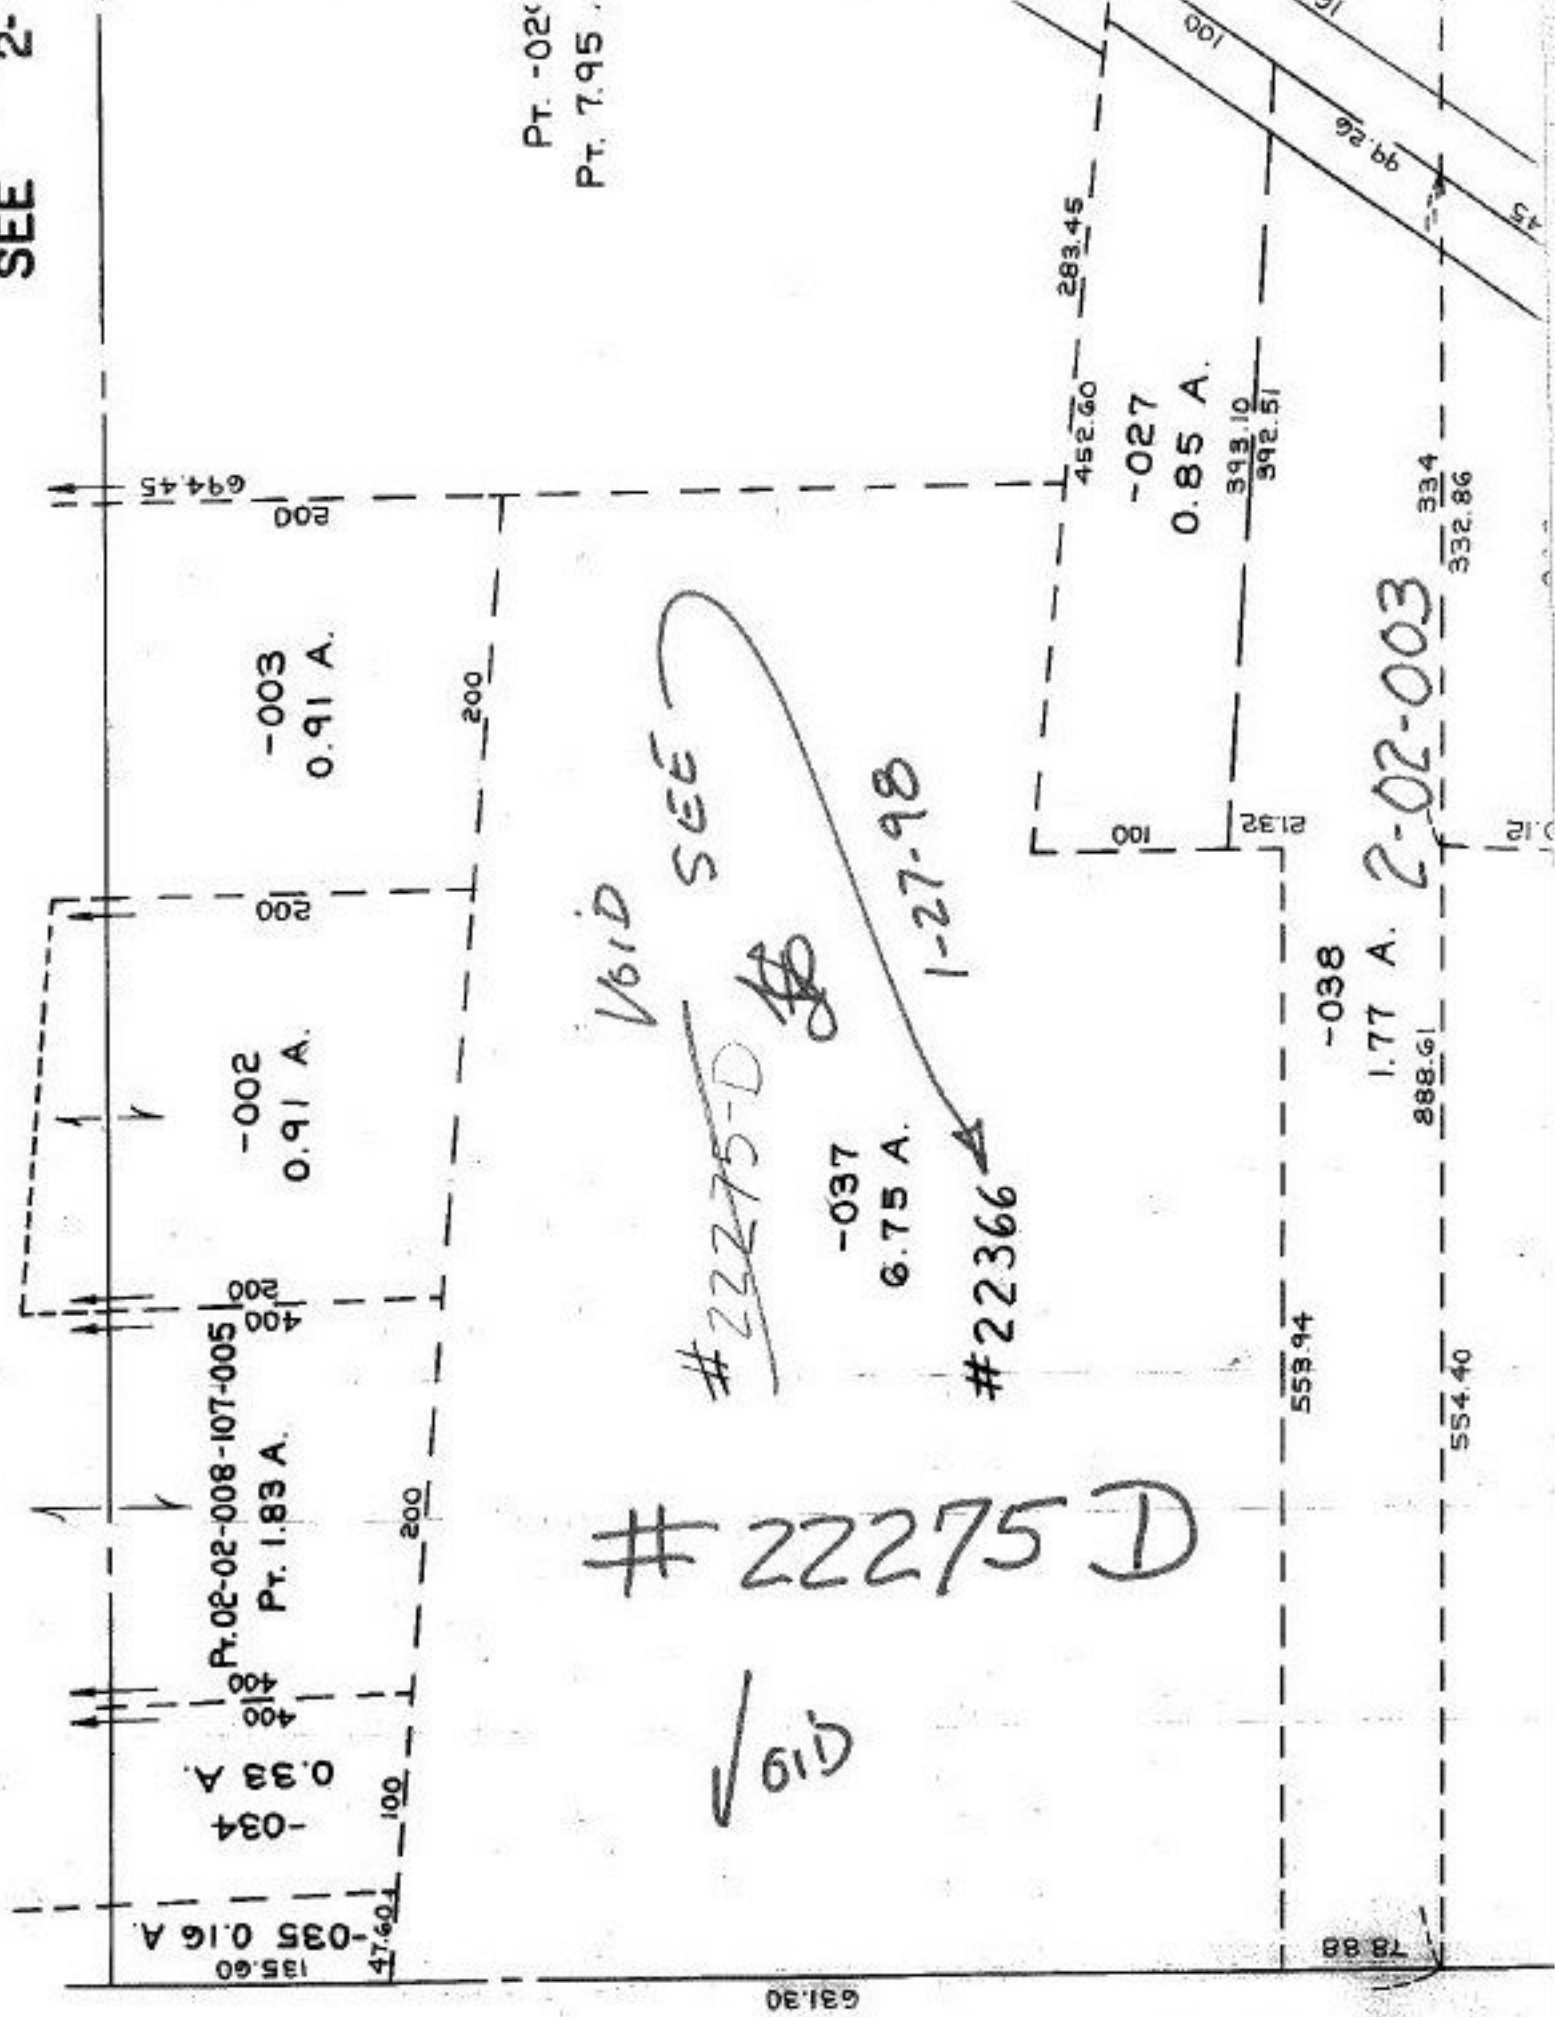

135.60  
47.60  
-035 0.16 A.

-034  
0.33 A.

Pt. 02-02-008-107-005  
Pt. 1.83 A.

-002  
0.91 A.

-003  
0.91 A.

#22275 D

VOID

VOID SEE  
~~#22275-D~~

-037  
6.75 A.

#22366

1-27-98

-027  
0.85 A.

-038  
1.77 A.

2-02-003

631.30

78.88

554.40

553.94

888.61

334  
332.86

452.60  
283.45

100

100

100

45