


#22278
NO. 22278

PARENT PARCEL: 05-00-019-000-028
CHILD PARCEL: 05-00-019-000-063, 064
STARTING POINT: cL of Oak Point Rd. & Cooper Foster Park Rd.

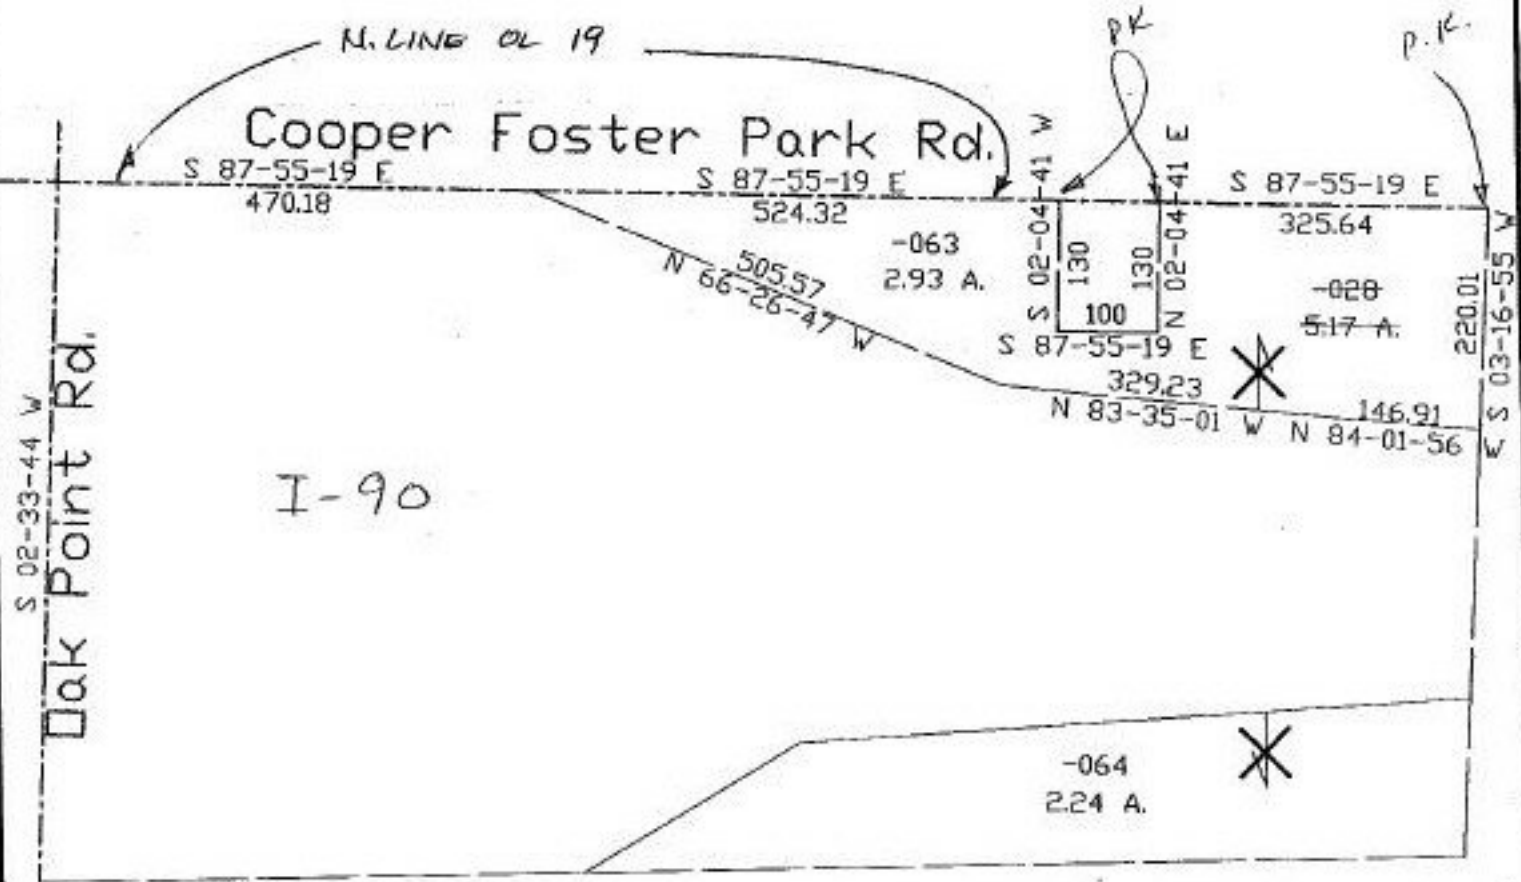

SPLITS/DEEDS PROCESSED
LORAIN COUNTY TAX MAP DEPARTMENT
226 MIDDLE AVE. ELYRIA, OHIO

SURVEYED BY: Douglas H. Mosley
CLOSURE: 0.04 per 10,000
MAP PAGE(S): 5-00-019-A
APPROVED BY: kac DATE: 8/22/97
SCALE: 1" = 200' PRIOR INSTRUMENT: OR 357/324