

#22278

SEE 5-00-020-A

PK


RD.

222


26705  
644.30

2.05

-028  
5.17 A. # 22278

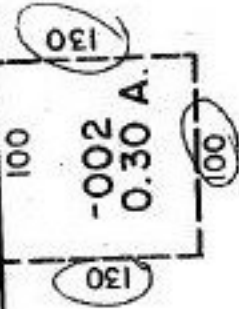

-063  
2.93 A.

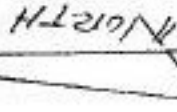

90

E -027  
15.53 A.

146.91

329.23

138.88

RD.

-064

2.24 A.

R PARK

994.50

505.58

1420.5  
1420.0

30  
FOSTER

OF 52A.32  
DNR FC & CONSERVATION

529.45

247.75

PLANT

127.28

141.40  
141.35

5-00-019-A

ATTNMENT  
36