
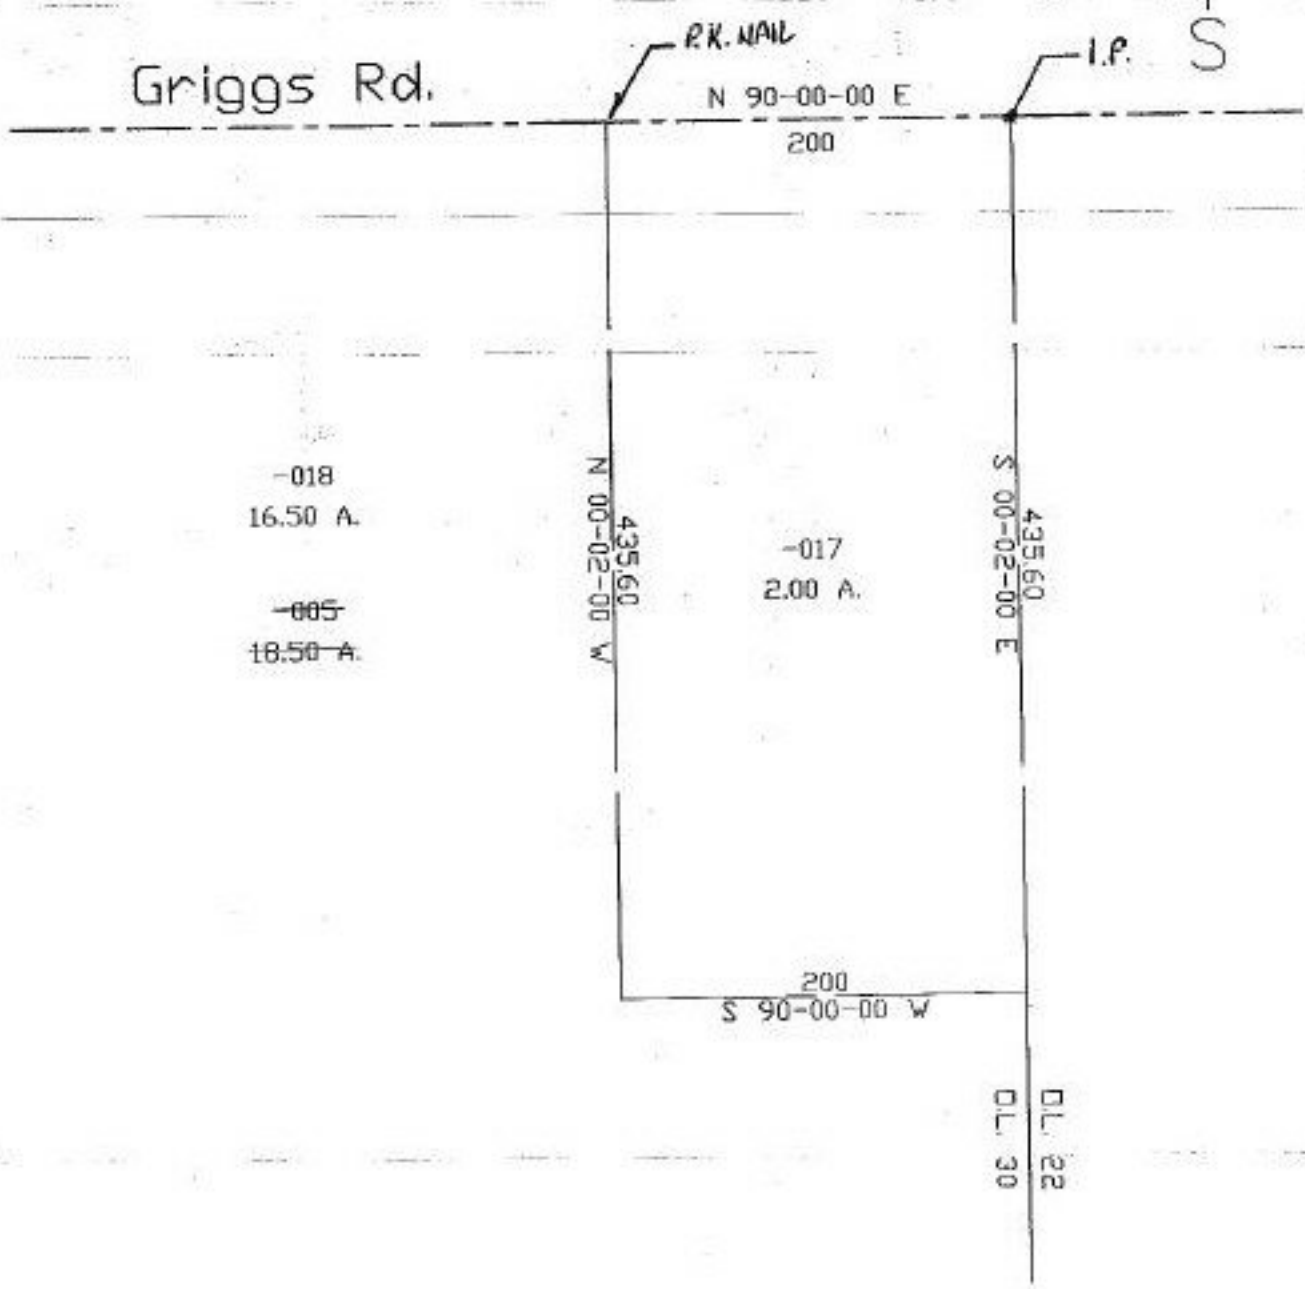


#22280  
NO. 22280

PARENT PARCEL: 21-05-030-000-005  
CHILD PARCEL: 21-05-030-000-017, 018  
STARTING POINT: NE corner of O.L. 30, Tract 5

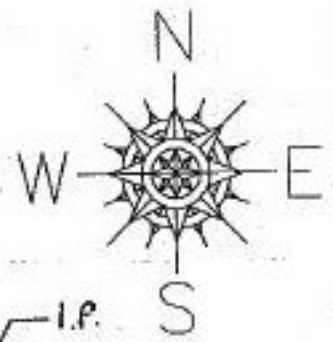

**SPLITS/DEEDS PROCESSED**  
LORAIN COUNTY TAX MAP DEPARTMENT  
226 MIDDLE AVE. ELYRIA, OHIO

SURVEYED BY: James B. Roberts  
CLOSURE: 0.00 per 10,000  
MAP PAGE(S): 21-05-030-B  
APPROVED BY: kac DATE: 9/22/97  
SCALE: 1" = 100' PRIOR INSTRUMENT: 1025/588