
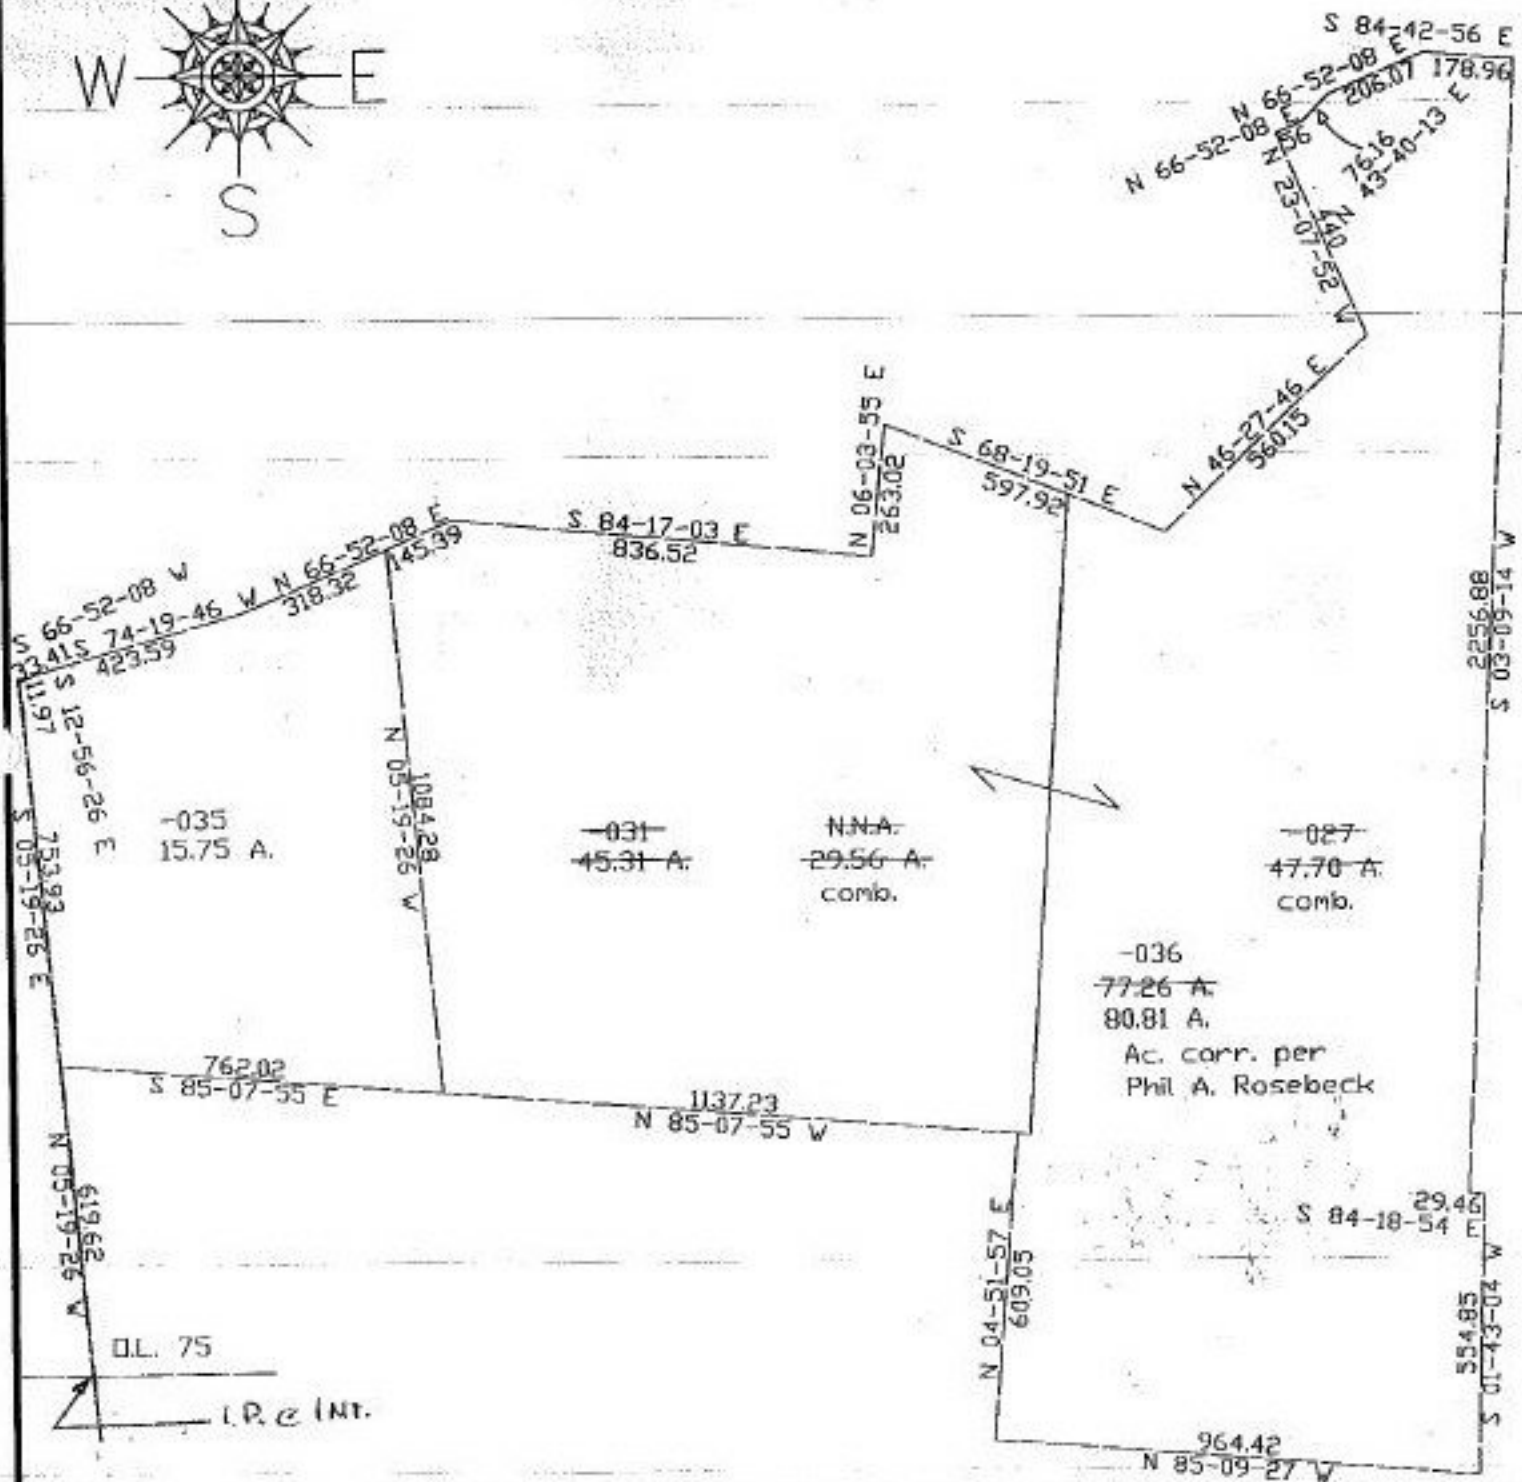


PARENT PARCEL: 01-00-075-000-031, 027
 CHILD PARCEL: 01-00-075-000-035, 036
 STARTING POINT: c.l. of Gifford Rd. & s. line of O.L. 75

#222881

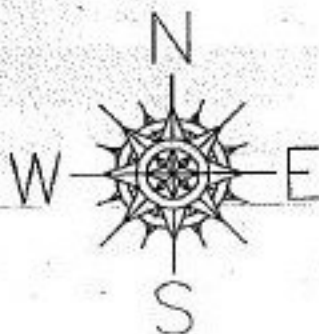

SPLITS/DEEDS PROCESSED
 LORAIN COUNTY TAX MAP DEPARTMENT
 226 MIDDLE AVE. ELYRIA, OHIO

SURVEYED BY: Phil A. Rosebeck
 CLOSURE: 0.02 per 10,000
 MAP PAGE(S): 1-K
 APPROVED BY: KAC DATE: 8/29/97
 SCALE: 1" = 400' PRIOR INSTRUMENT: