


PARENT PARCEL: 17-20-017-000-006, 014, 015
 CHILD PARCEL: 17-20-017-000-027 thru 033
 STARTING POINT: cl. of Medina-Norwalk Rd. & Gore-Orphanage Rd.

22283
 NO. 22283

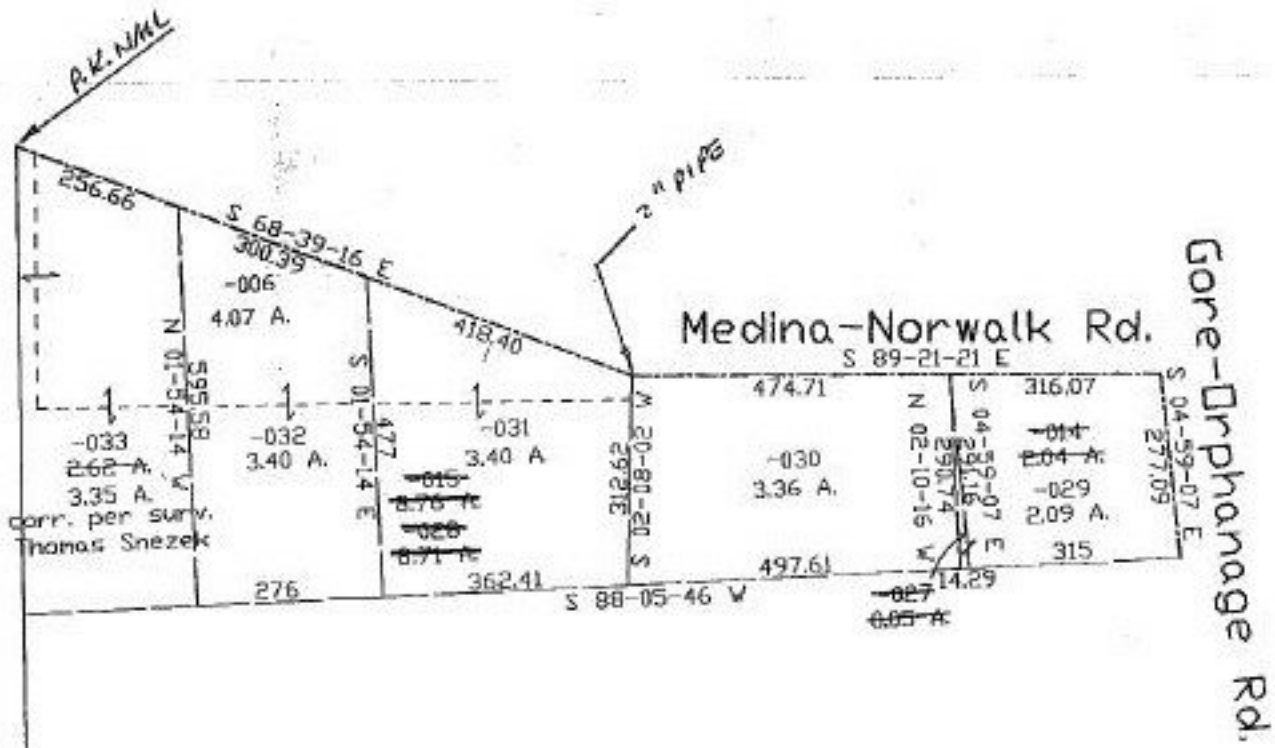

SPLITS/DEEDS PROCESSED
 LORAIN COUNTY TAX MAP DEPARTMENT
 226 MIDDLE AVE. ELYRIA, OHIO

SURVEYED BY: Thomas M. Szezek
 CLOSURE: 0.12:10.000
 MAP PAGE(S): 17-E
 APPROVED BY: kac DATE: 9/23/97
 SCALE: 1" = 300' PRIOR INSTRUMENT: OR 361-70