


#22285-D

APPROVED
LORAIN CO.
MAP DEPT.
DATE 9-26-97
BY: 12-00-019-
J. McMain
22285-D

#22285-D

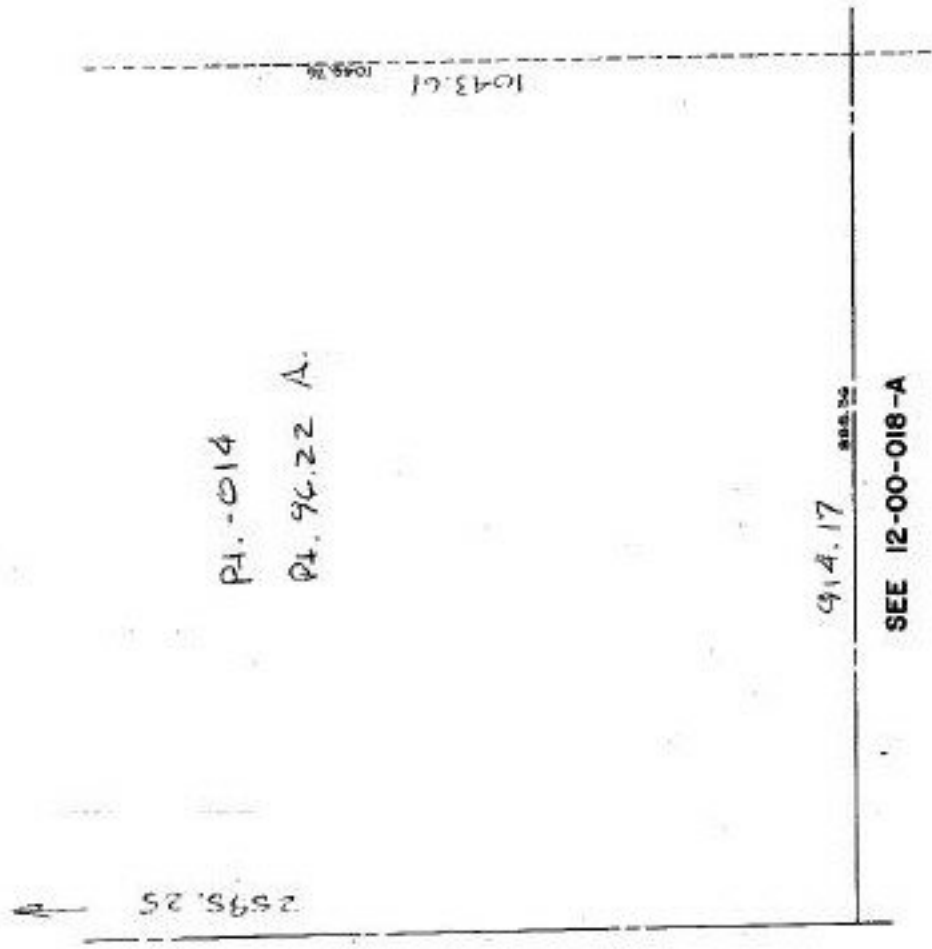

COLUMBIA T

SCALE: 1" = 100'

W. PART OF LOT 19

REVISED 5/3/00
2-00-019-A