


#22285-D

SEE 12-00-020-A

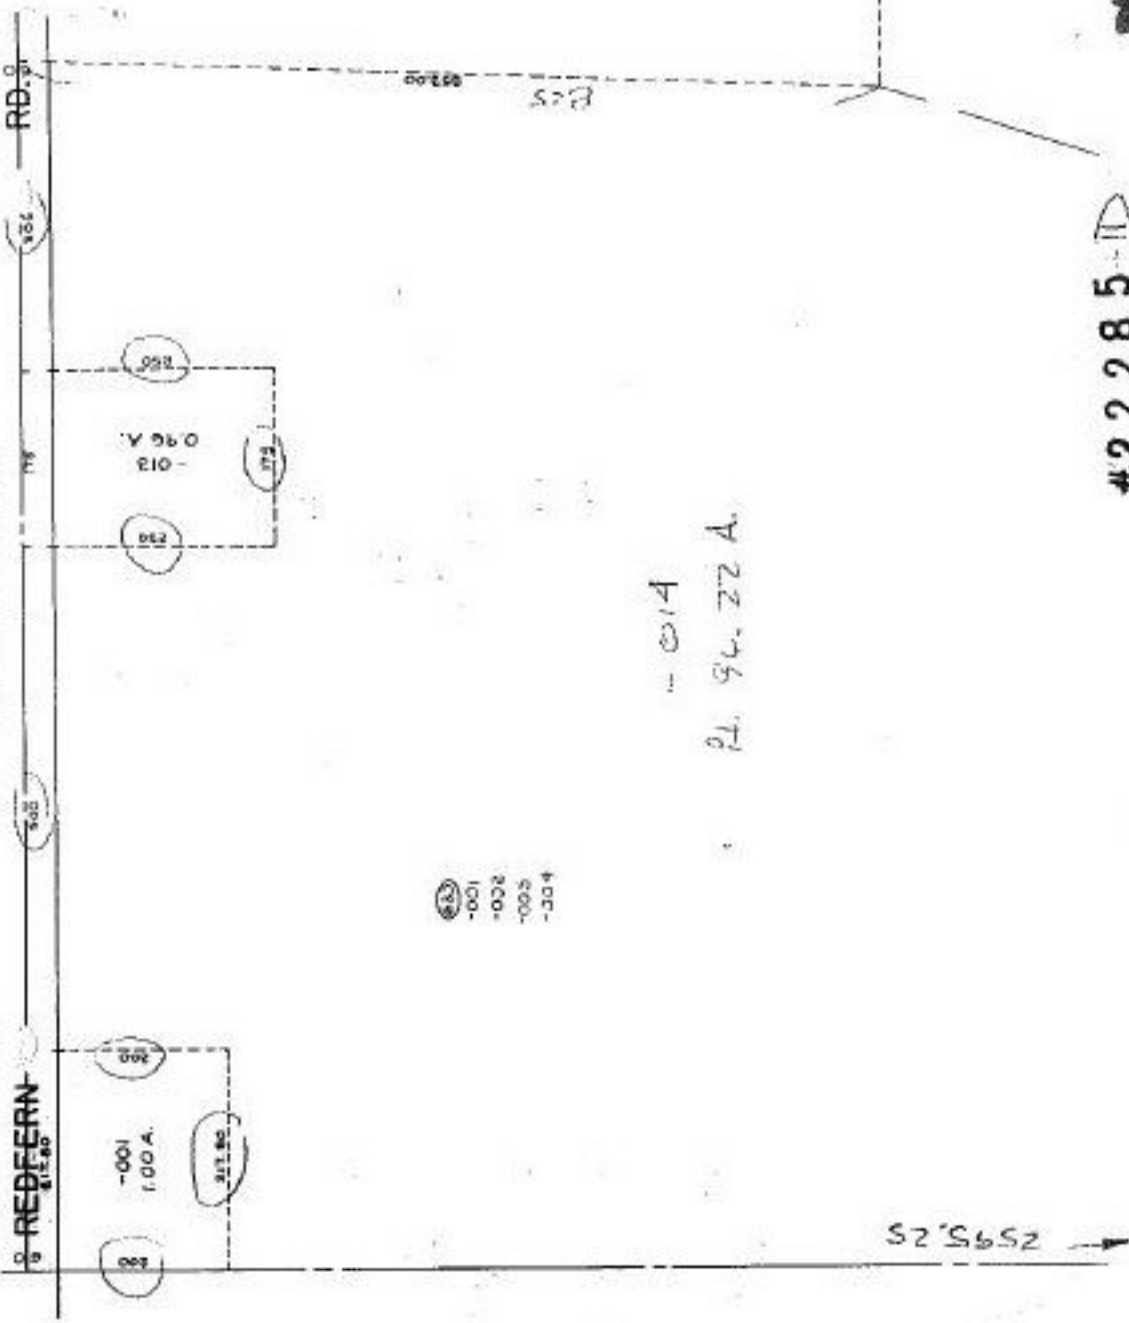

#22285-D

APPROVED
LORAIN CO.
MAP DEPT.
DATE 9-26-97
BY 12-00-019-A
BY T. M. Klein
#22285-D

ACRE CORP.