


PARENT PARCEL: 06-25-002-111-147

CHILD PARCEL: 06-25-002-111-151 152 153

STARTING POINT:



NO. 22287

?

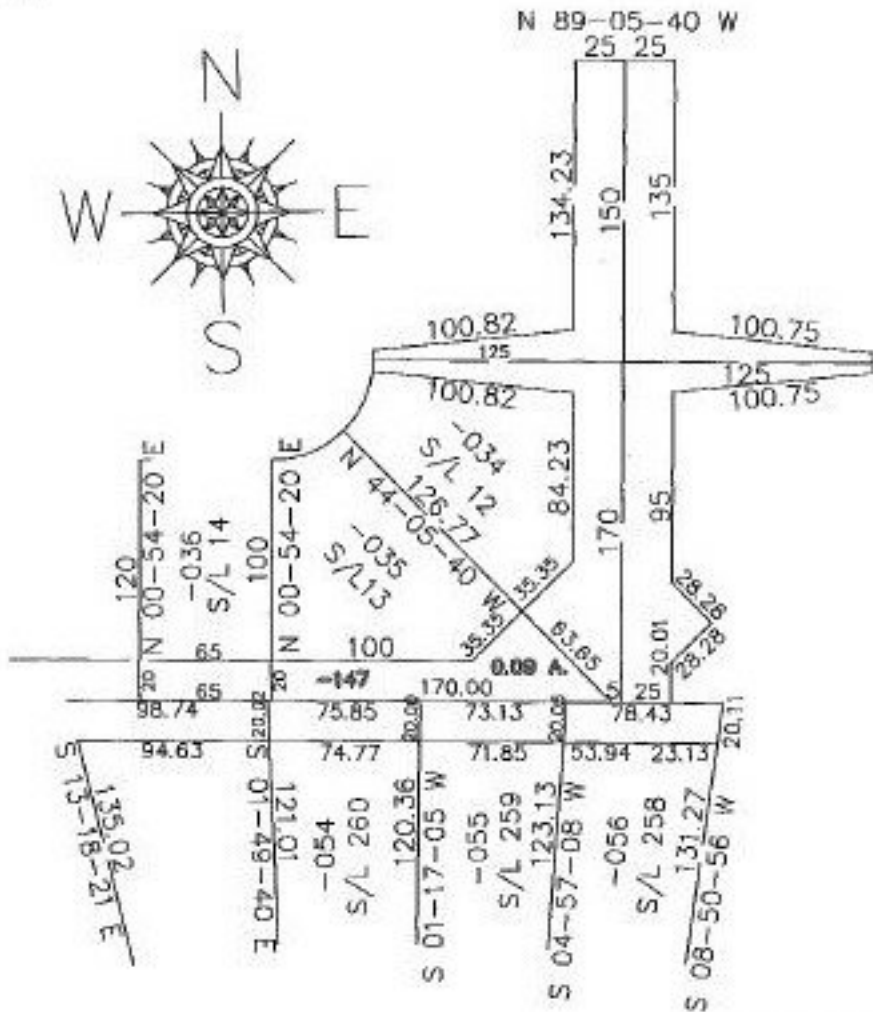

SCALE 1=50

* SEE # 22086 FOR CREATION OF -147

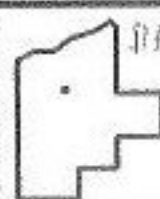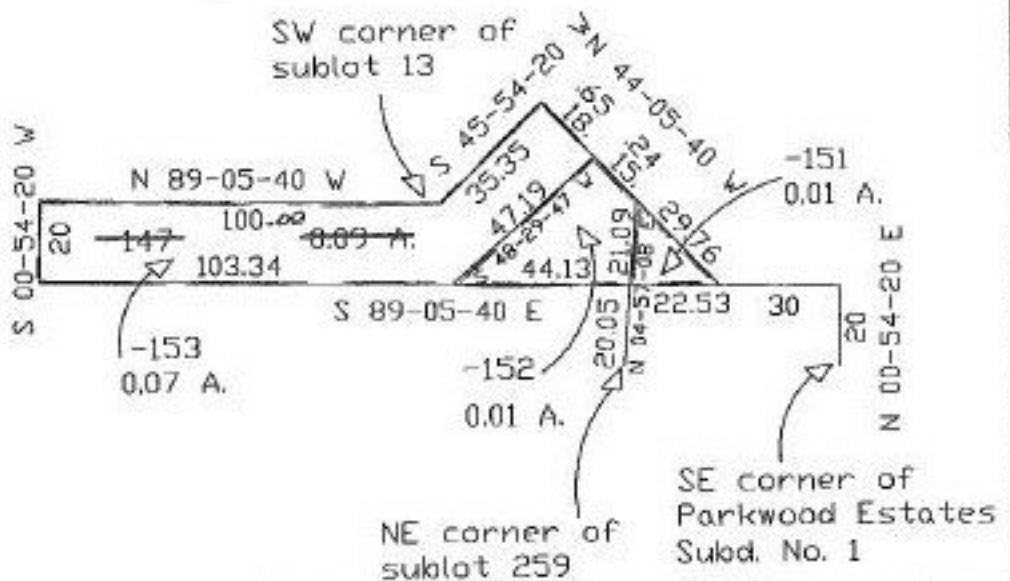

11-13-98

SPLITS/DEEDS PROCESSED
LORAIN COUNTY TAX MAP DEPARTMENT
 226 MIDDLE AVE. ELYRIA, OHIO

SURVEYED BY: Rodger G. Simon
 CLOSURE: 0.96 A.
 MAP PAGE(S): 6-141
 APPROVED BY: kac DATE: 10/2/97
 SCALE: 1"=100 PRIOR INSTRUMENT: 470830

970470830