

BROWNHELM STATION


#22288



ACRE CORR. PER SURVEY	
EARL HUNTER, P.S. # 7537	
DATED FEB. 1995	
CL. LINE.	
PRIOR INST. DV 336/833	
REF. DV 860/630	

Pt. -243
~~Pt. 52.0TA.~~
 56.53 A.

* THIS PARCEL CONTINUES
 ONTO PAGE 1-00-017-B

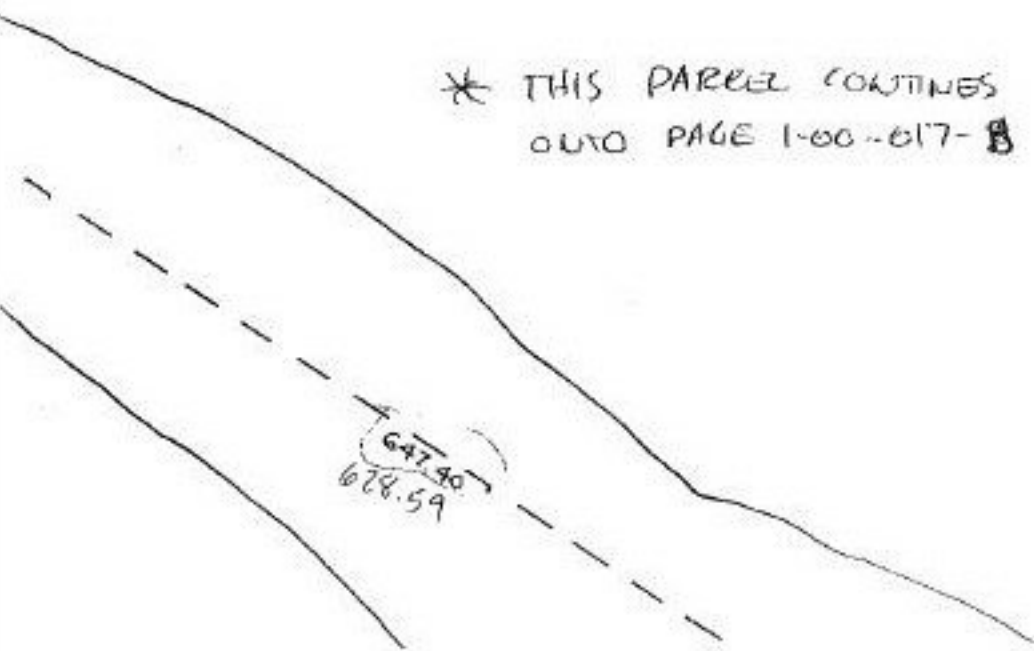

#22288

ACRE CORR.

APPROVED	
LORAIN CO.	
MAP DEPT.	
DATE	10-28-97
SCALE	1-00-017-A
BY	T. McLean
NO. MAP	22288