


#22291-X

SEE II-A

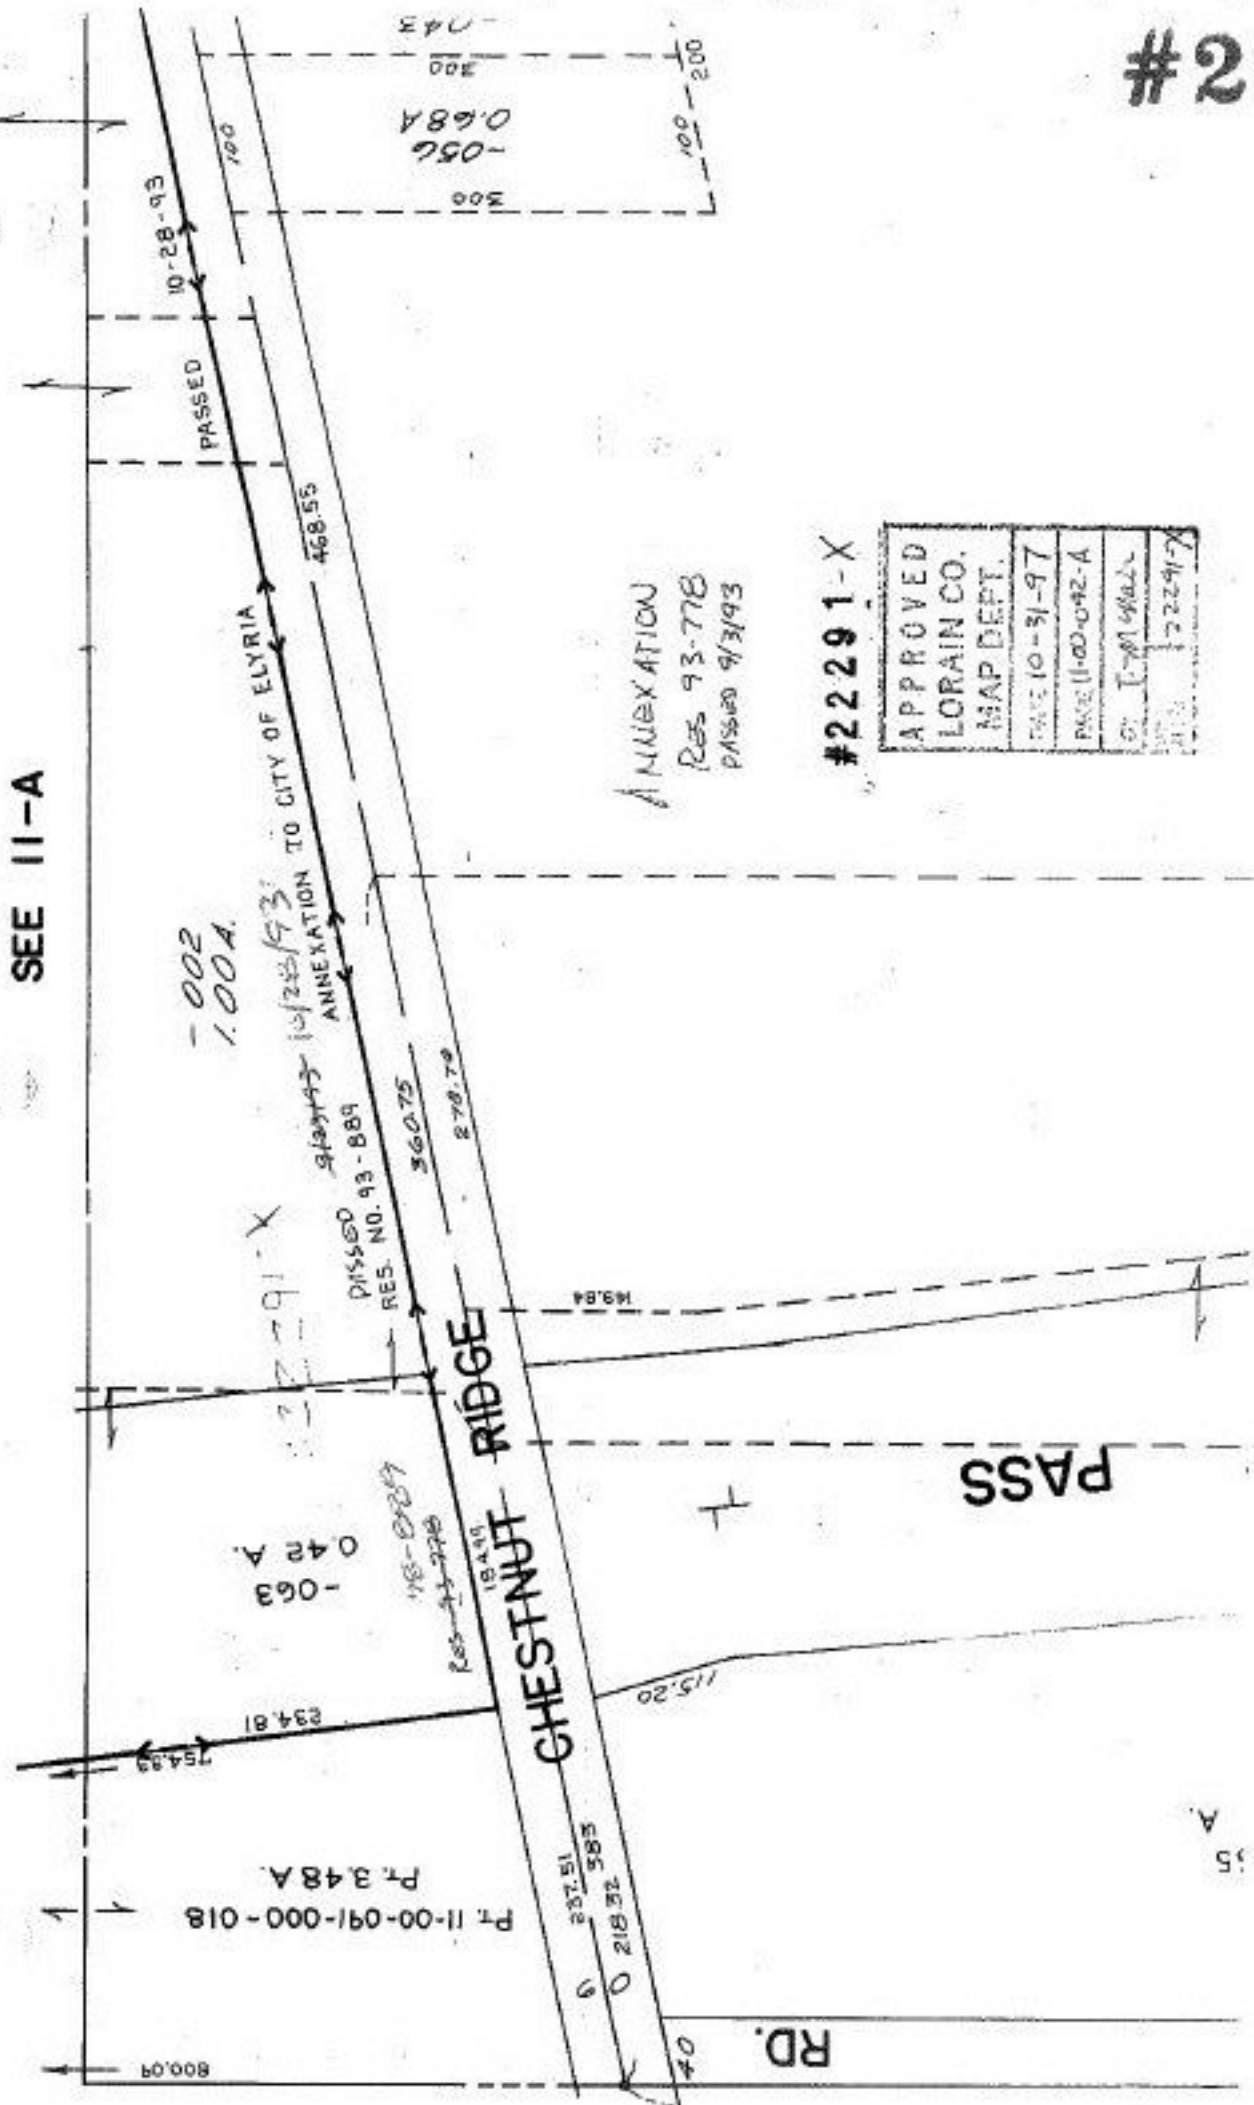

ANNEXATION  
RES 93-778  
PASSED 9/3/93

#22291-X

|                     |
|---------------------|
| APPROVED            |
| LORAIN CO.          |
| MAP DEPT.           |
| DATE 10-31-97       |
| PROJECT 11-00-092-A |
| BY T.M. [Signature] |
| DATE 10-31-97       |