


#22292 A

SEE 16-00-091-A

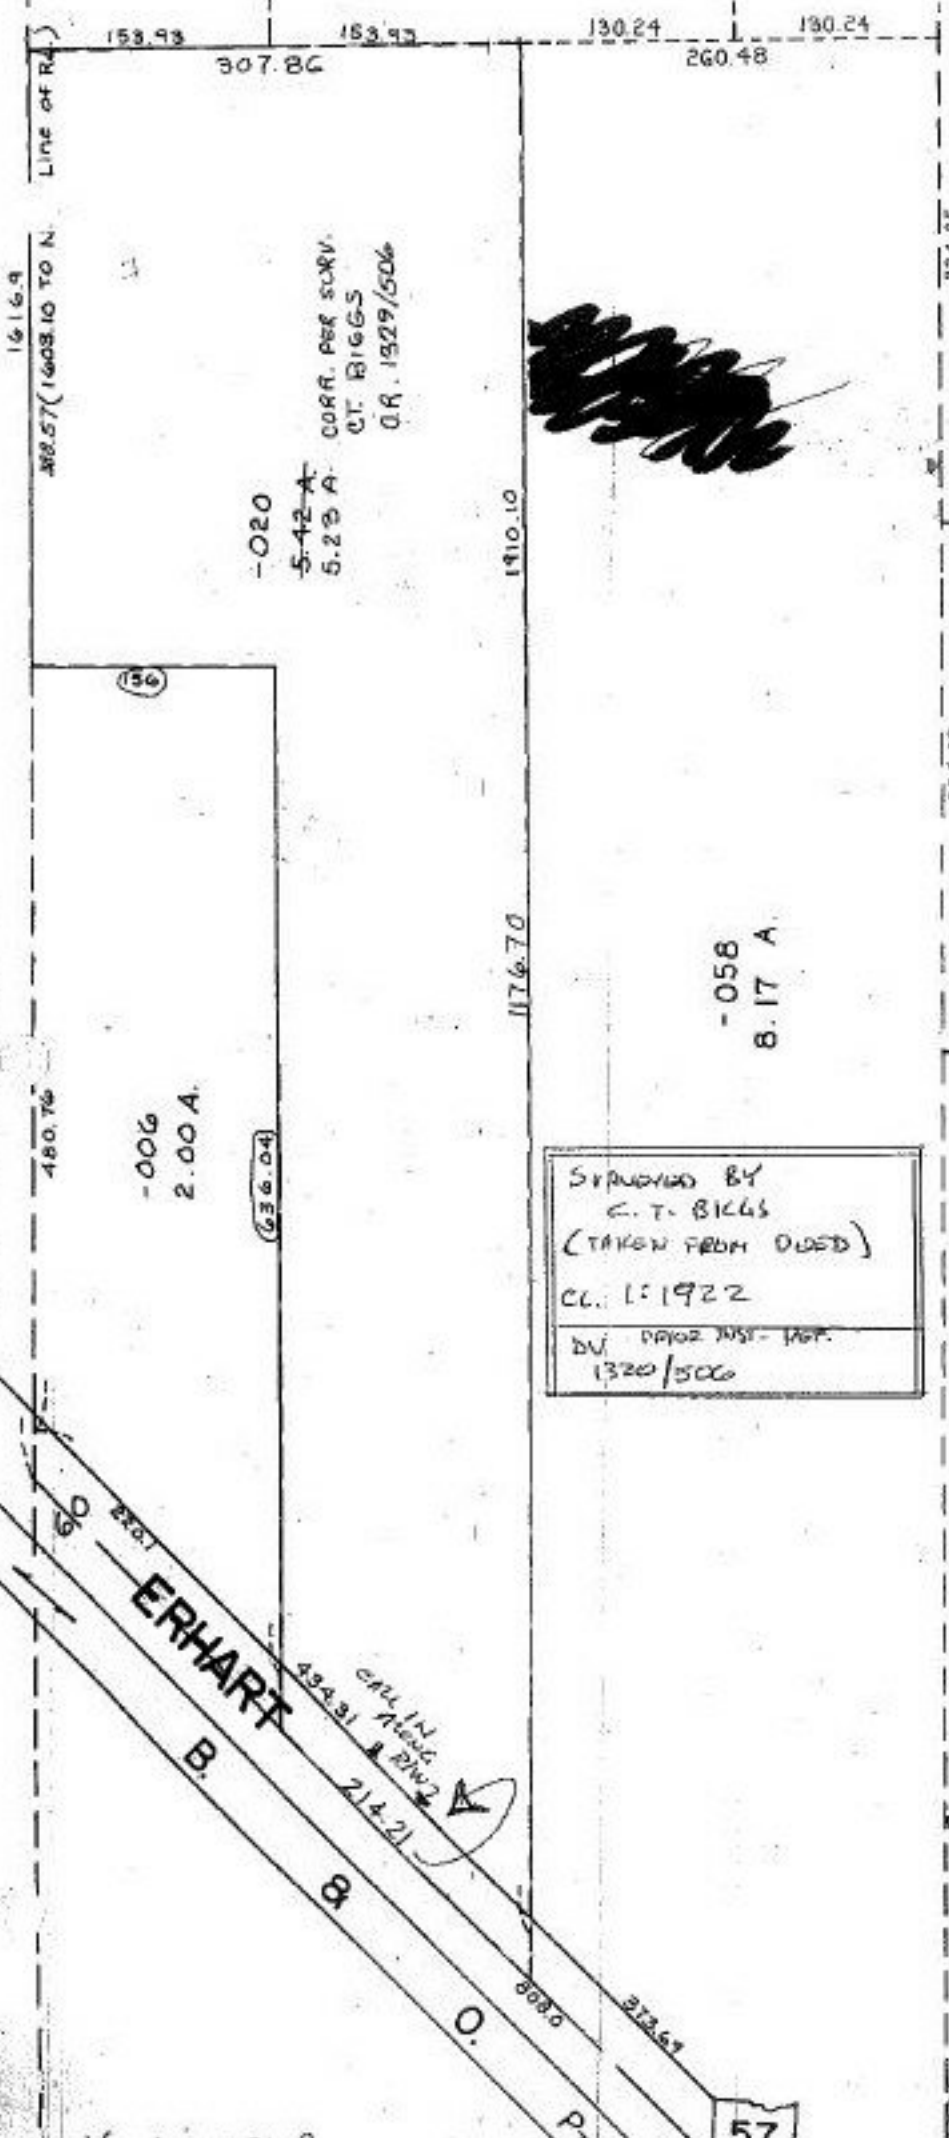

SURVEYED BY
 C. T. BIGGS
 (TAKEN FROM DEED)
 CL. 1:1922
 BY D. P. W. INST. 1607
 1320/500

ACREAGE CORR.
 #22292-A

APPROVED
 LORAIN CO.
 MAP DEPT
 DATE 10/4/97
 PAGE 16-00-091-B
 BY K. Colbert

REDUCED
 SIZE
 COPY