


SEE 3-F

PT. -031
PT. 7.74 A.



1964.44
2400.75

101

210
-030 0.36 A. 74

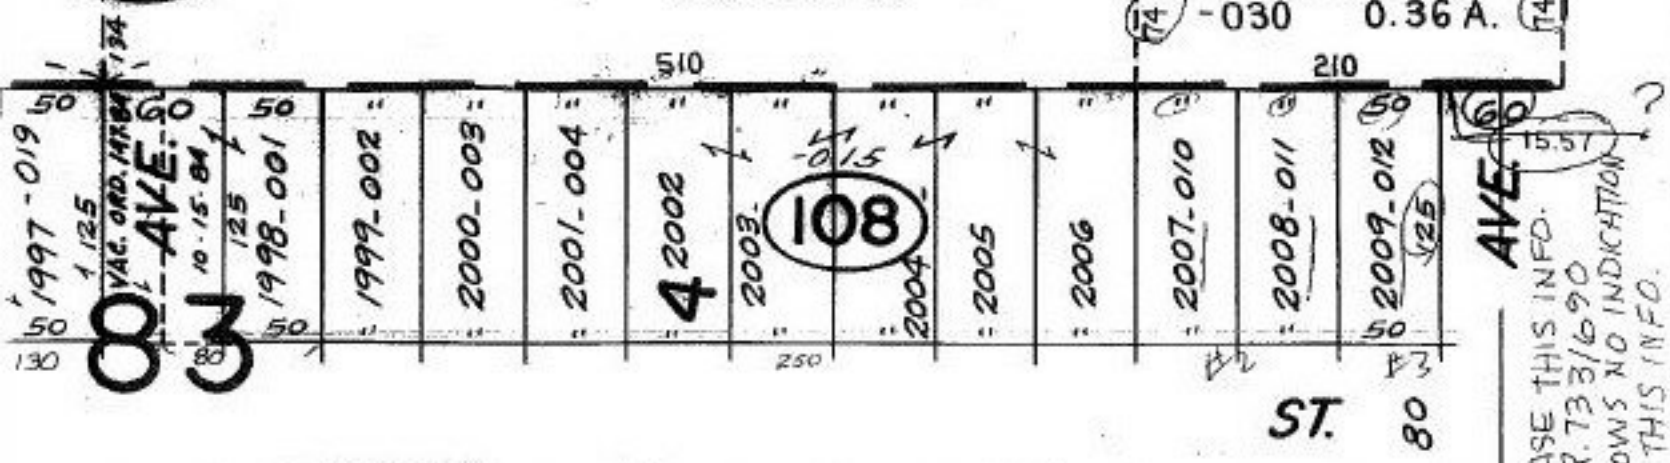

ERASE THIS INFO.
O.R. 733/690
SHOWS NO INDICATION
OF THIS INFO.

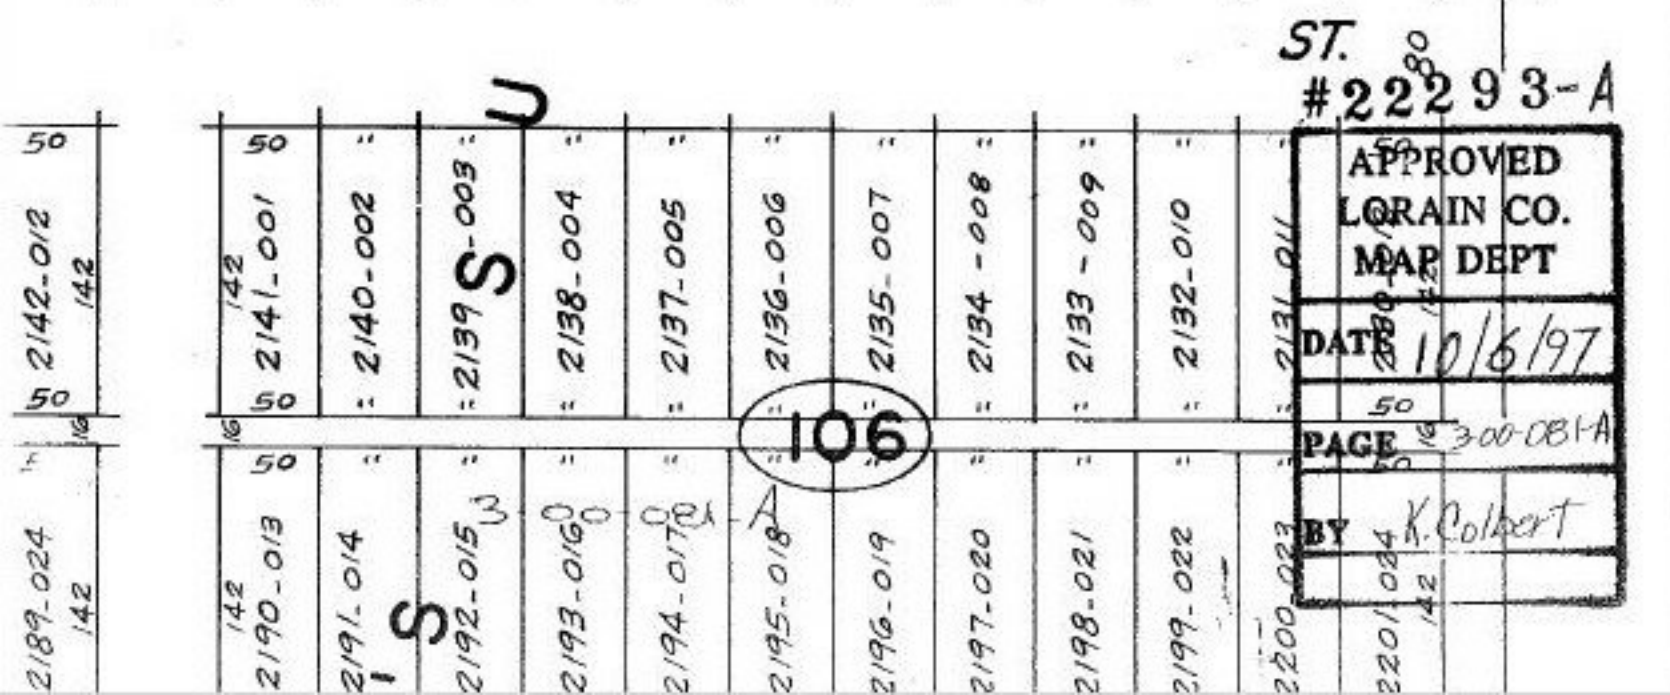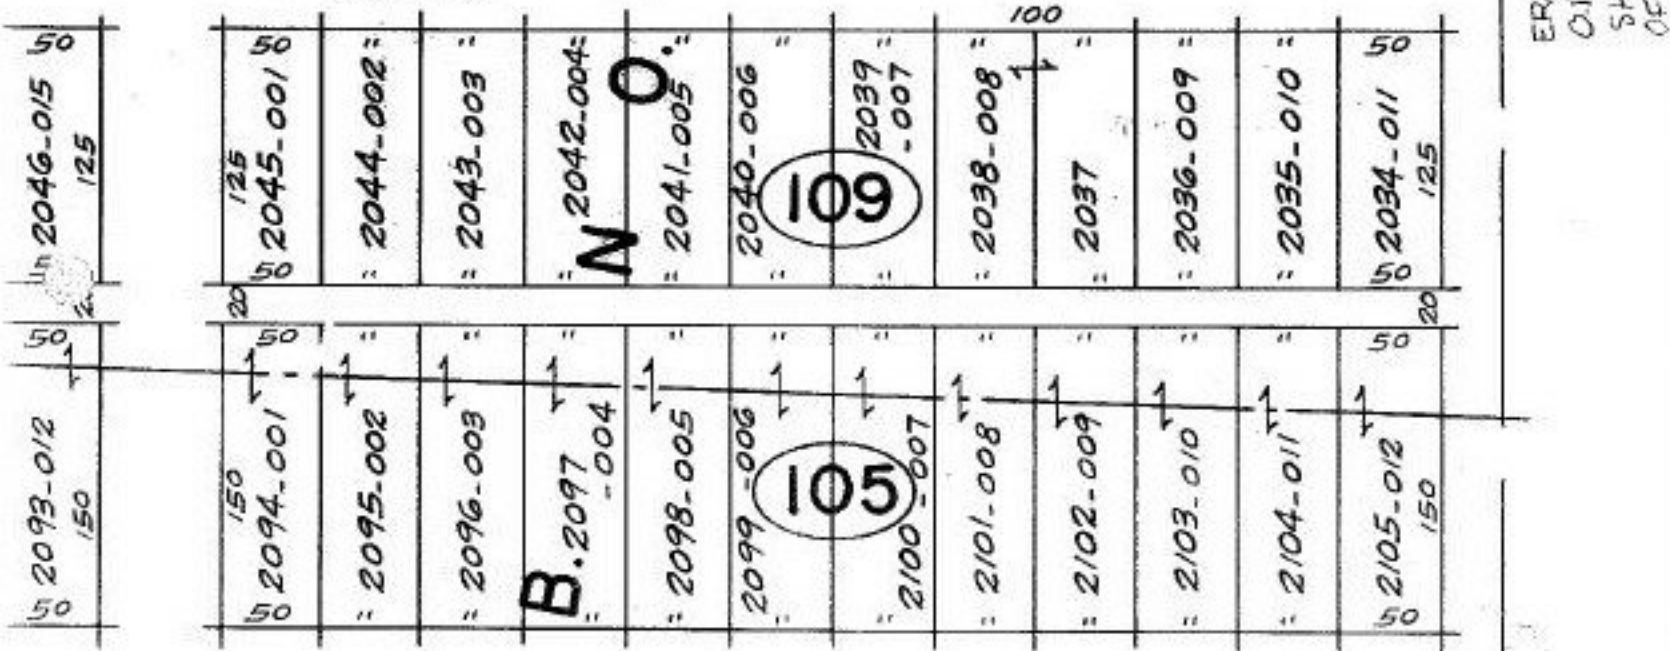

APPROVED LORAIN CO. MAP DEPT	
DATE	10/6/97
PAGE	300-081A
BY	K. Colbert