


#22298-A

NO. 22298-A

PARENT PARCEL: 18-00-009-000-045

CHILD PARCEL:

STARTING POINT: cl. of Howley Rd. & nw corner of O.L. 9

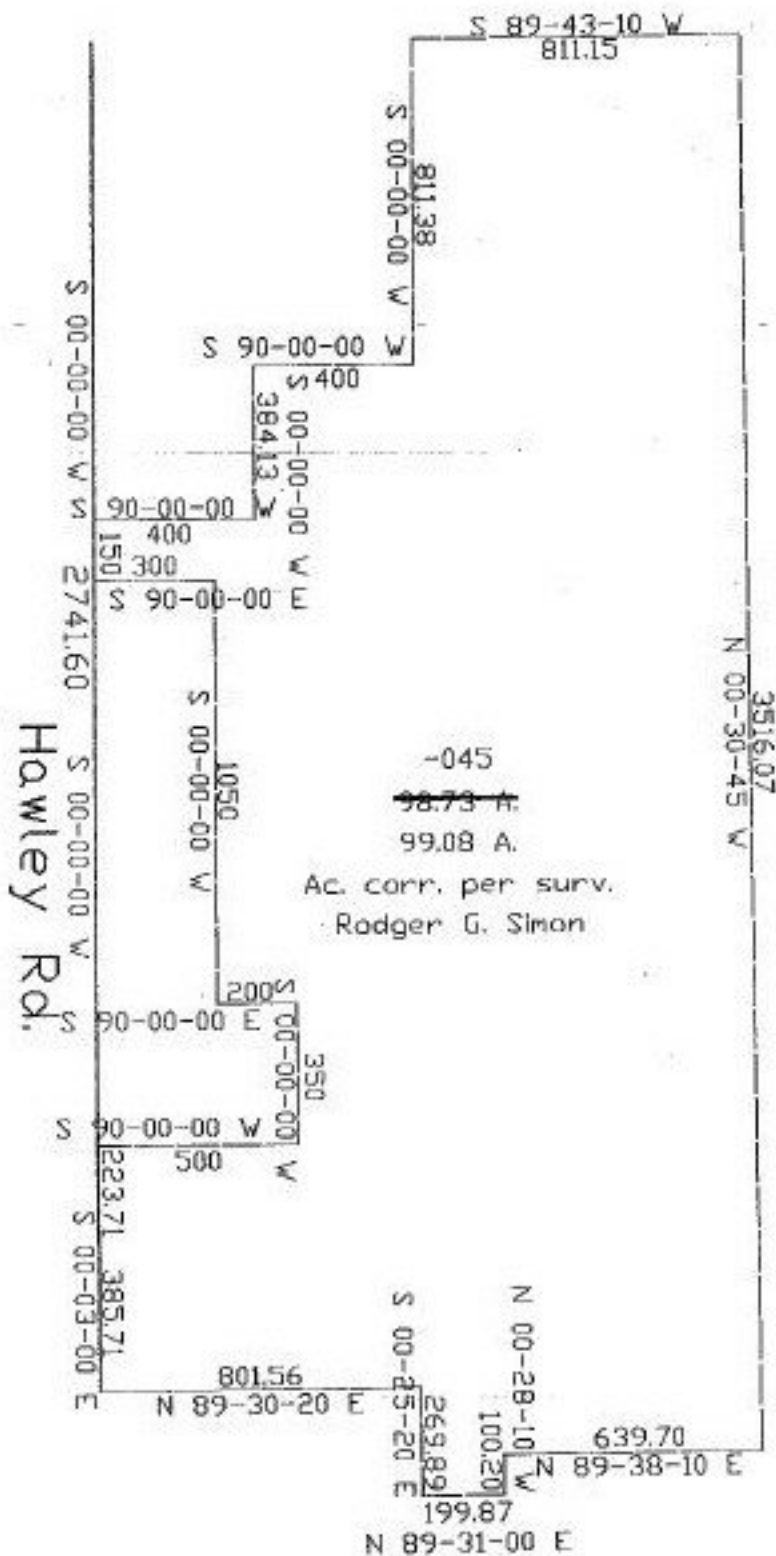

Howley Rd.



SPLITS/DEEDS PROCESSED

LORAIN COUNTY TAX MAP DEPARTMENT
226 MIDDLE AVE. ELYRIA, OHIO

SURVEYED BY: Rodger G. Simon

CLOSURE: 0.03:10.000

MAP PAGE(S): 18-0

APPROVED BY: kac DATE: 10/7/97

SCALE: 1" = 500' PRIOR INSTRUMENT: ^{of} 1379/365