


PARENT PARCEL: 02-03-007-000-021

CHILD PARCEL: 02-03-007-000-090 thru 092

STARTING POINT: \_\_\_\_\_

NO. 22299

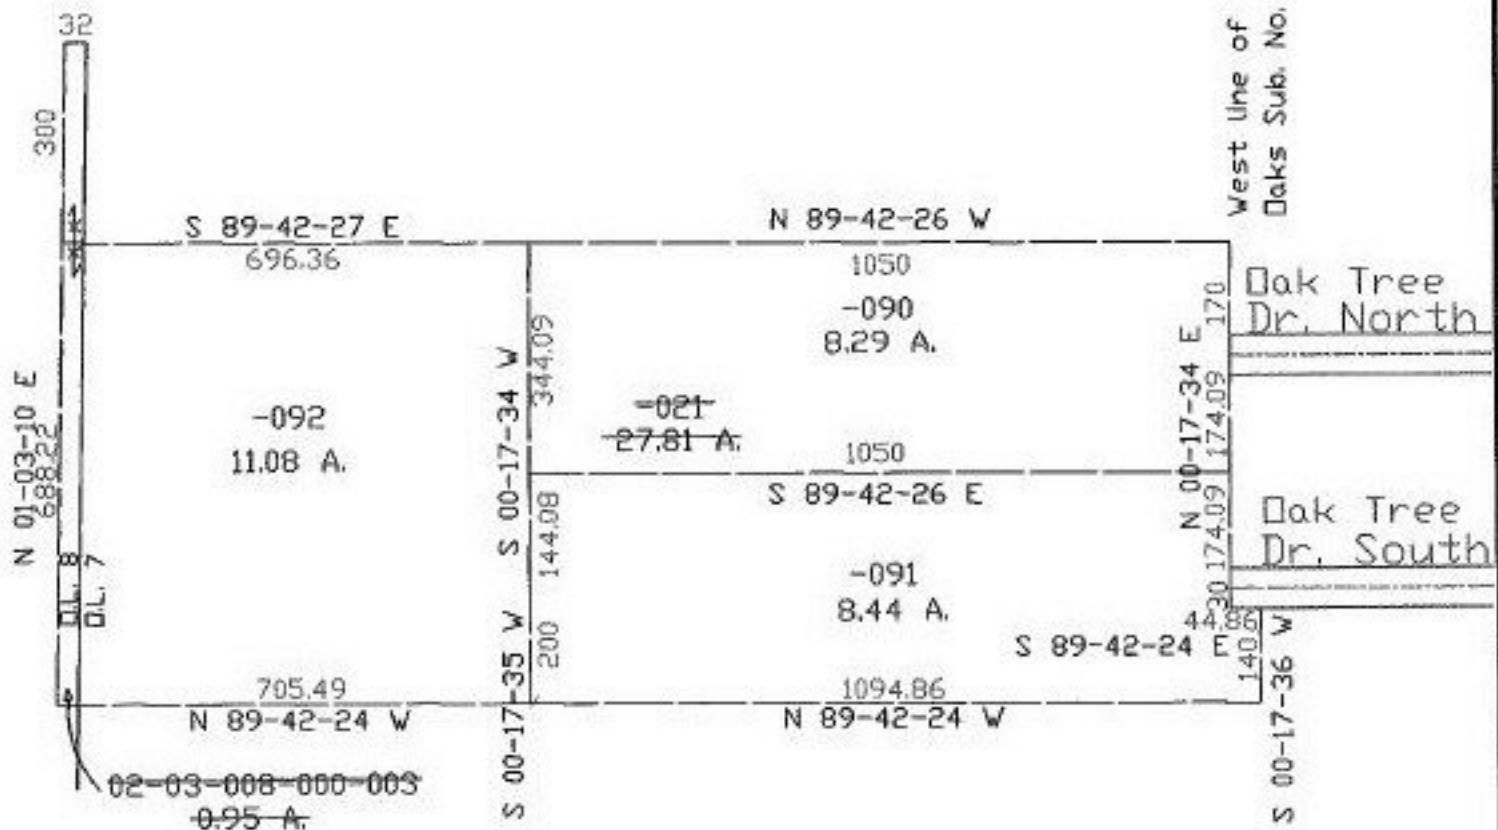

**SPLITS/DEEDS PROCESSED**  
**LORAIN COUNTY TAX MAP DEPARTMENT**  
 226 MIDDLE AVE. ELYRIA, OHIO

SURVEYED BY: Patrick A. McGannon

CLOSURE: 0.31:10.000

MAP PAGE(S): 2-E

APPROVED BY: kac DATE: 10/7/97

SCALE: 1" = 300' PRIOR INSTRUMENT: \_\_\_\_\_