


PARENT PARCEL: 02-03-007-000-021

CHILD PARCEL: 02-03-007-000-060 thru 062

STARTING POINT:


NO. 22299

#22 299

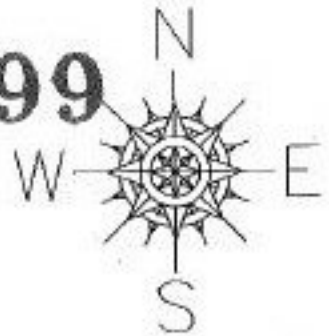

All I.P. shown were found by P. McGannon

• = iron pin

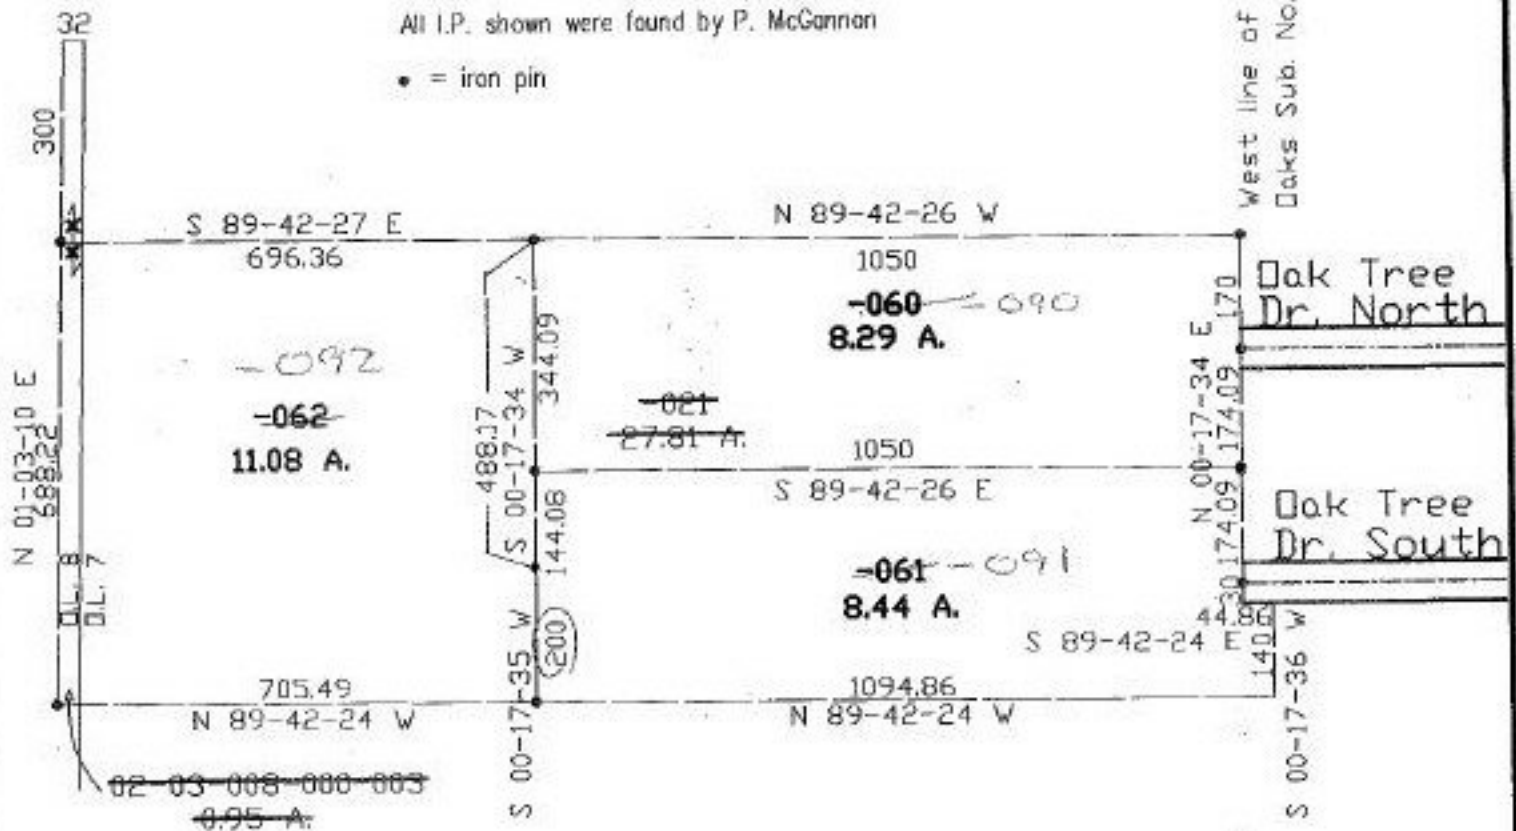

**SPLITS/DEEDS PROCESSED**  
 LORAIN COUNTY TAX MAP DEPARTMENT  
 226 MIDDLE AVE. ELYRIA, OHIO

SURVEYED BY: Patrick A. McGannon  
 CLOSURE: 0.31:10.000  
 MAP PAGE(S): 2-E  
 APPROVED BY: kac DATE: 10/7/97  
 SCALE: 1" = 300' PRIOR INSTRUMENT: