


#22303
NO. 22303


PARENT PARCEL: 16-00-045-000-033

CHILD PARCEL: 16-00-045-000-034, 035

STARTING POINT: cl. of SR 57/303 & cl. of Wooster-Avon Lake Rd.

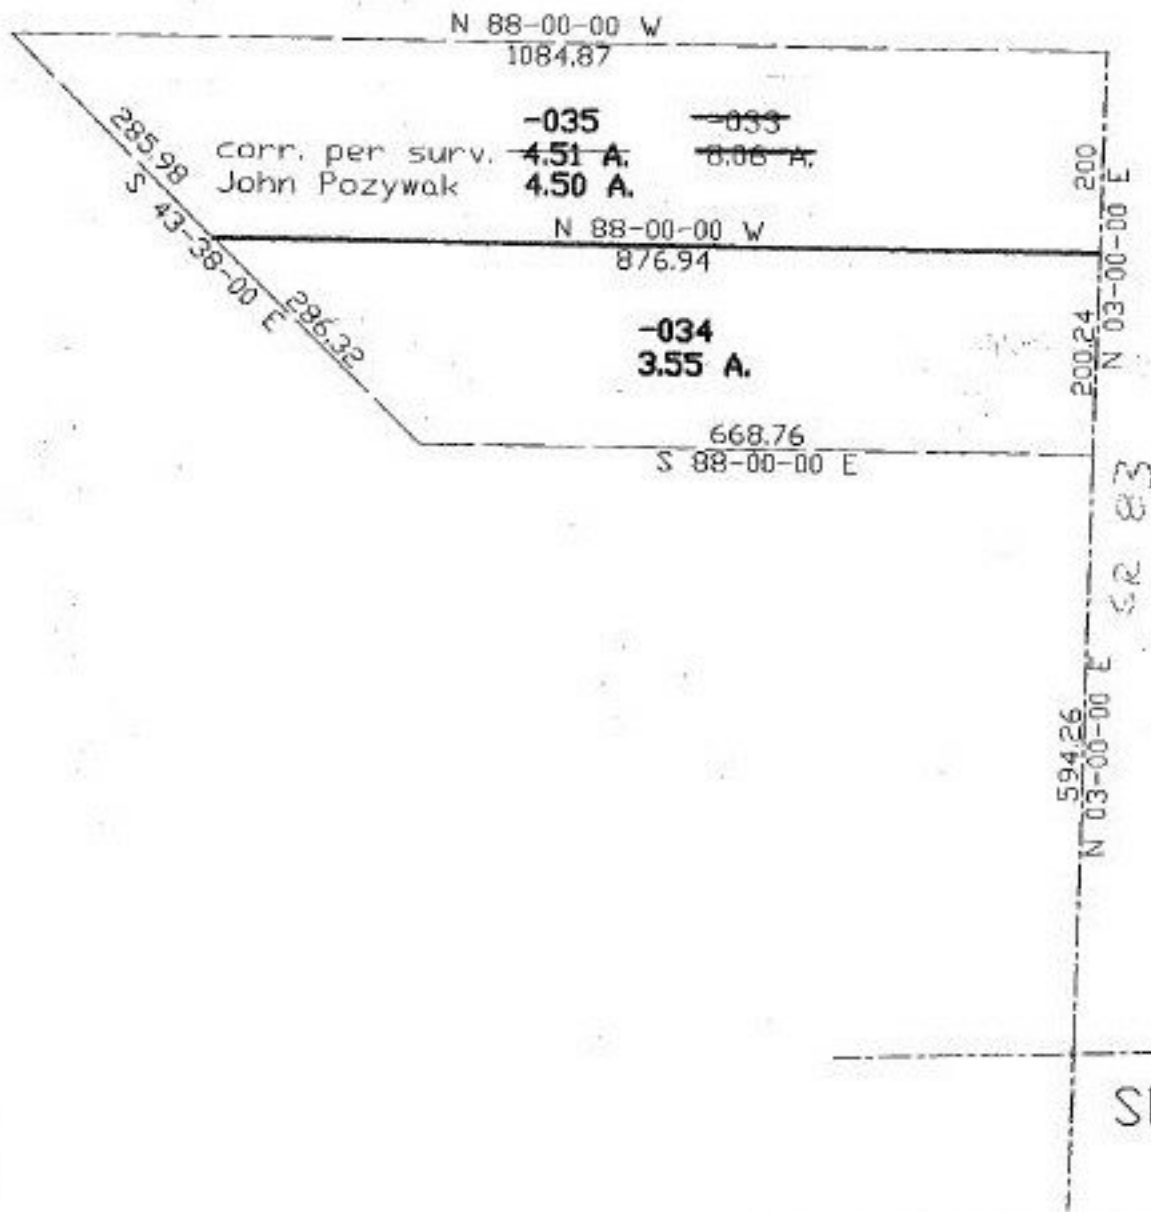

SR 57/303

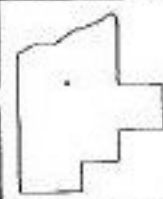

SPLITS/DEEDS PROCESSED
LORAIN COUNTY TAX MAP DEPARTMENT
226 MIDDLE AVE. ELYRIA, OHIO

SURVEYED BY:	John Pozywak
CLOSURE:	0.01:10.000
MAP PAGE(S):	16-00-045-8
APPROVED BY:	koc
DATE:	10/15/97
SCALE:	1" = 200
PRIOR INSTRUMENT:	170/384