


RAIN

NW corner
EDMUNDE WEST

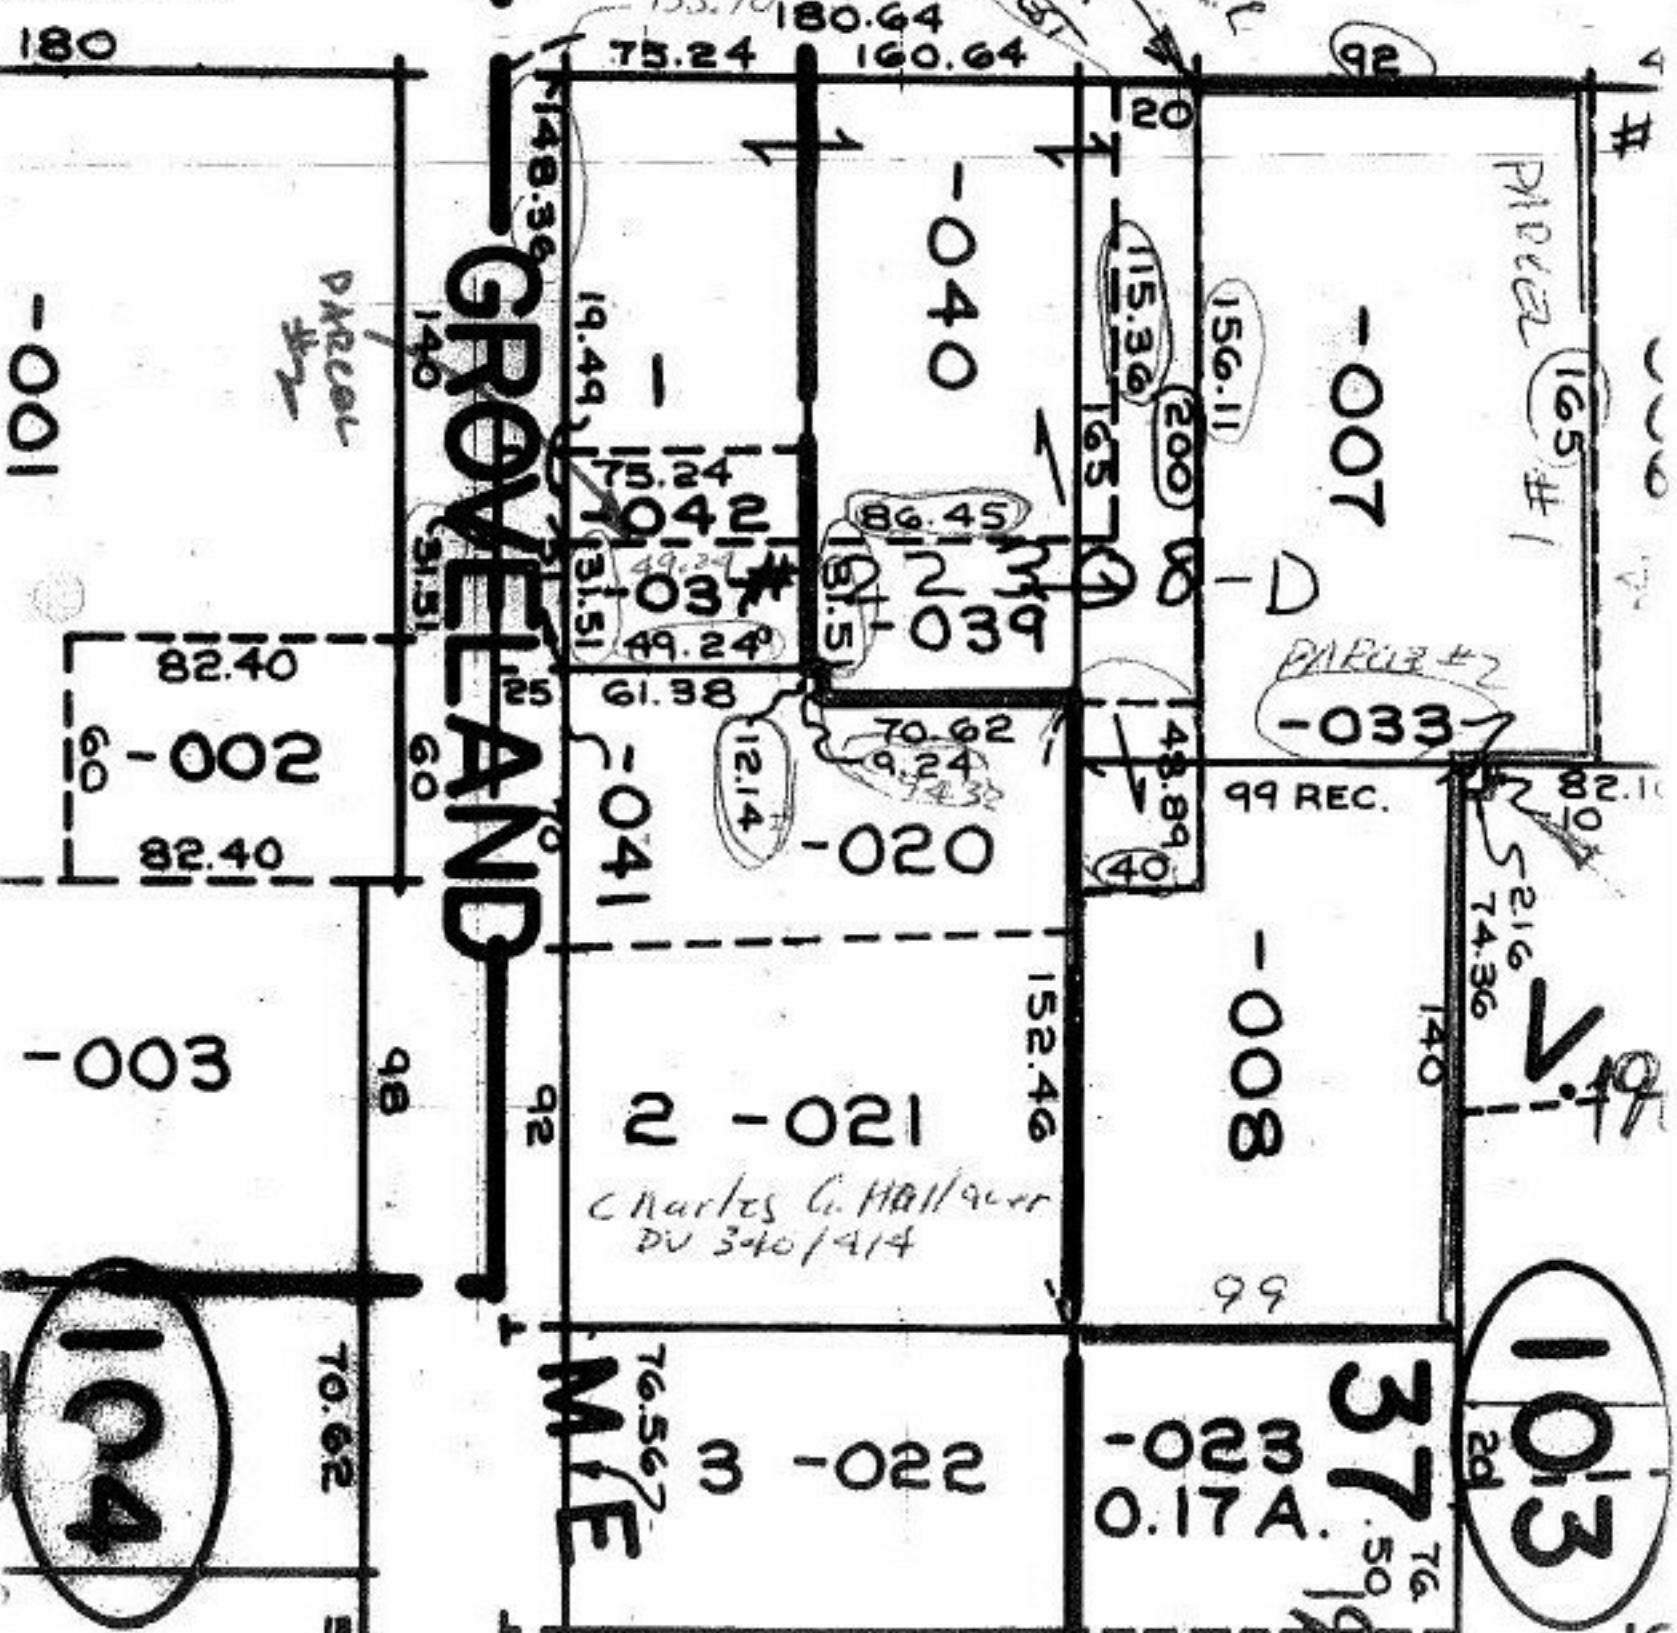

-001

-002

-003

104

GROVELAND

135.70 180.64
75.24 160.64

-040

-007

PARCEL #1

PARCEL #2

-033

99 REC.

-042

-043

-041

039

-020

-008

2 - 021

Charles C. Hall/owner
DU 3040/414

3 - 022

0.17A

37.50

1013

70.62

76.56

5

1

1