


OLD TAX MAP - CBERLIN Pg. 21

M.W. 1888  
EDW. 1897

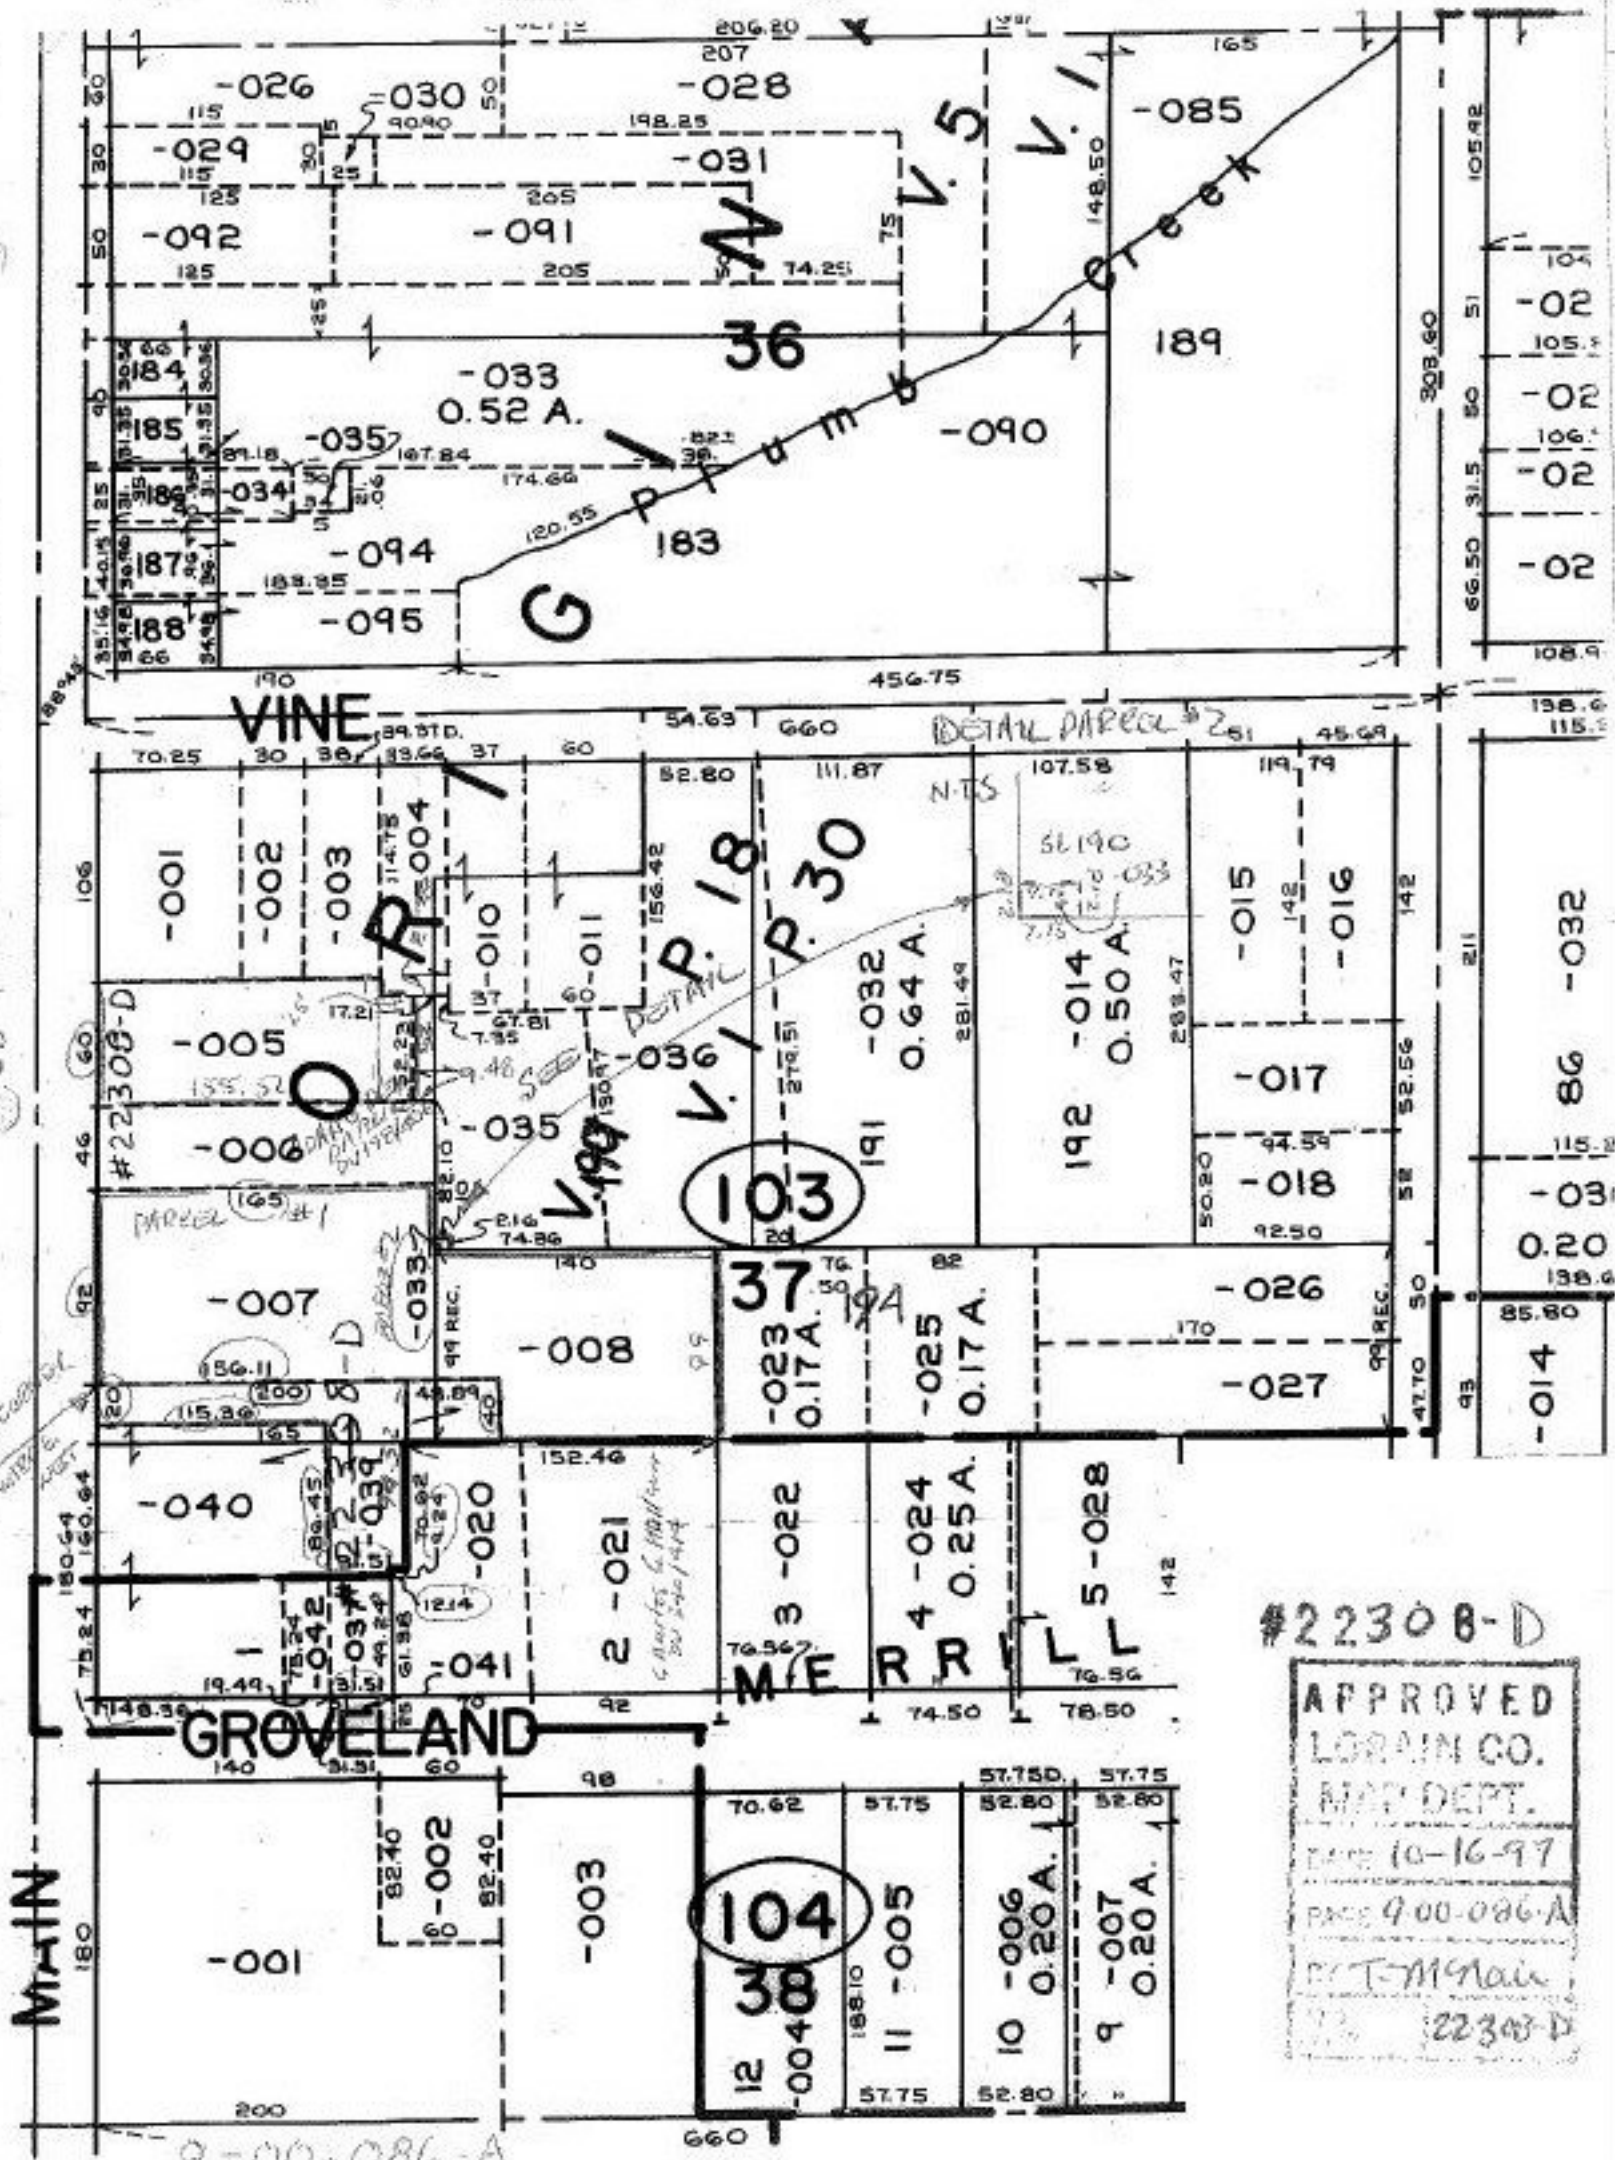

9-00-086-A

#22308-D

APPROVED  
 LORAIN CO.  
 MAP DEPT.  
 DATE 10-16-97  
 PMS 900-086-A  
 RT-Main  
 22308-D