


#22312-D

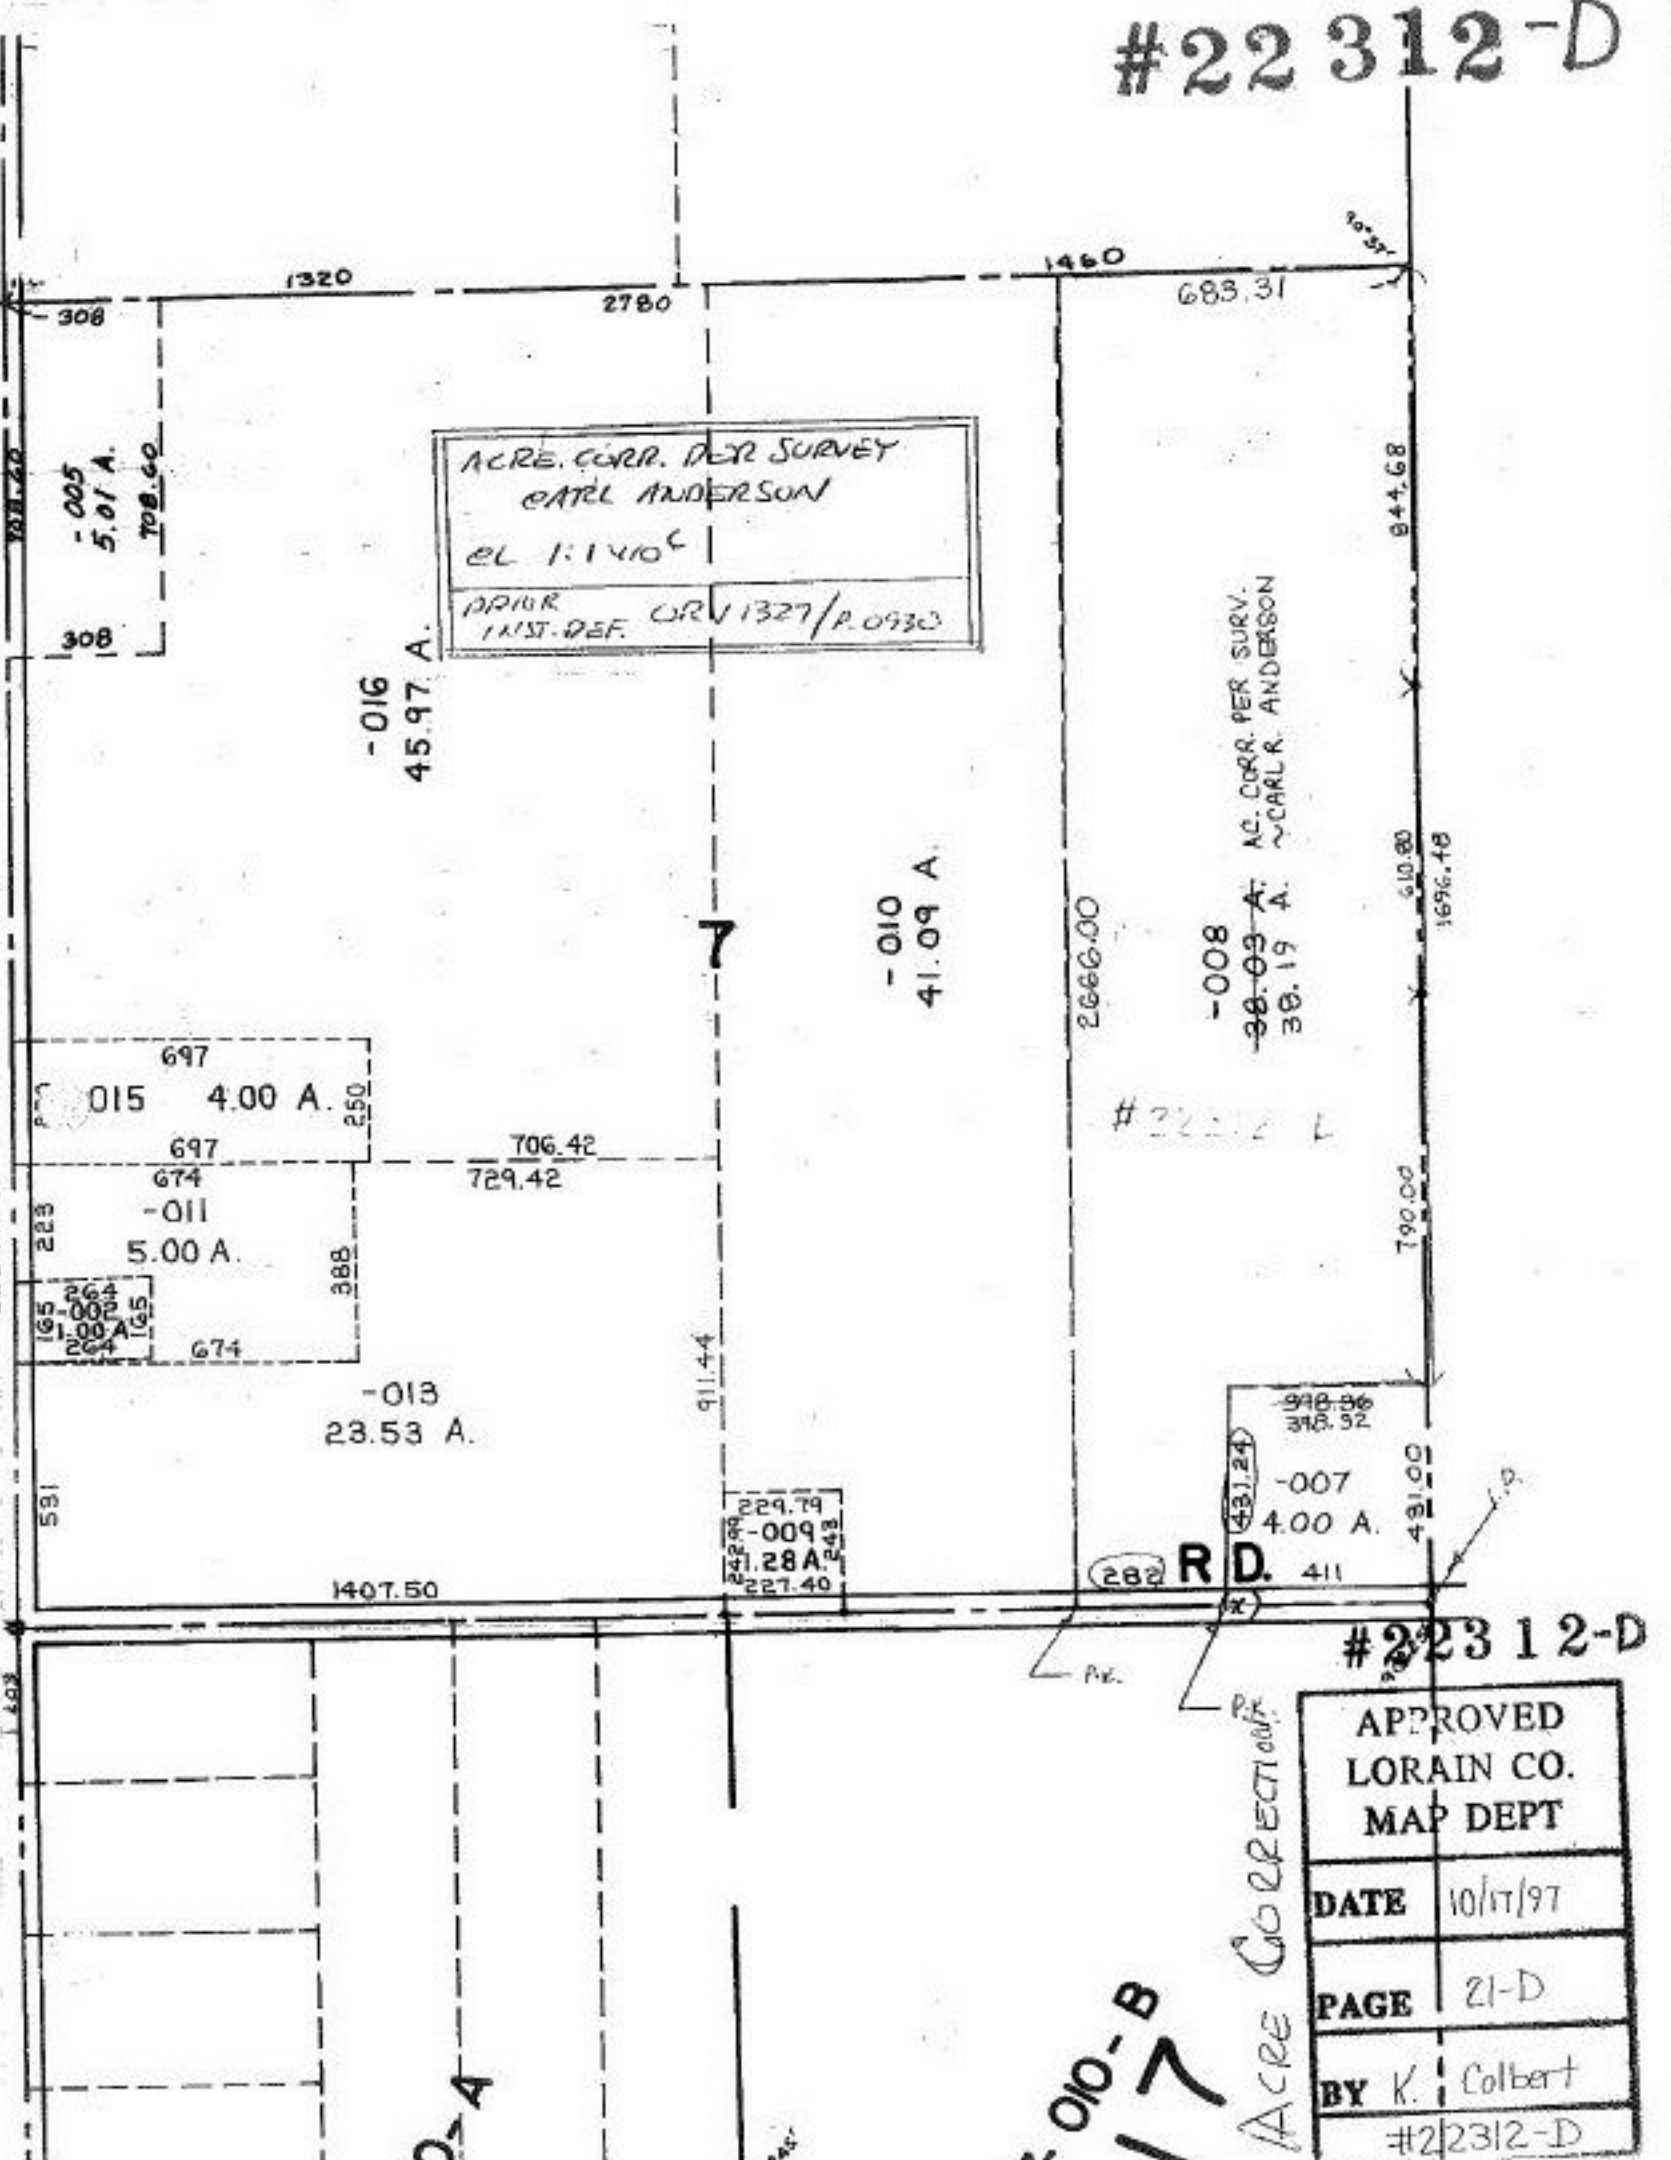

ACRE CORR. PER SURVEY
 CARL ANDERSON
 EL 1:1410
 PRIOR INST. DEF. CRV 1327/P. 0930

-016
 45.97 A.

-010
 41.09 A.

-008
 AC. CORR. PER SURV.
 CARL R. ANDERSON
 38.19 A.

015 4.00 A.

-011
 5.00 A.

-013
 23.53 A.

-007
 4.00 A.

RD. 411

#22312-D

APPROVED LORAIN CO. MAP DEPT	
DATE	10/17/97
PAGE	21-D
BY	K. Colbert
#22312-D	

-010-B
 17

ACRE COLLECTION