

#22319


NO. 22319

PARENT PARCEL: 04-00-008-101-033, 043  
CHILD PARCEL: 04-00-008-101-048  
STARTING POINT: cl. of Center Rd. & cl. of Webber Rd.



# COMBINATION

E. LINE SEC 8 →

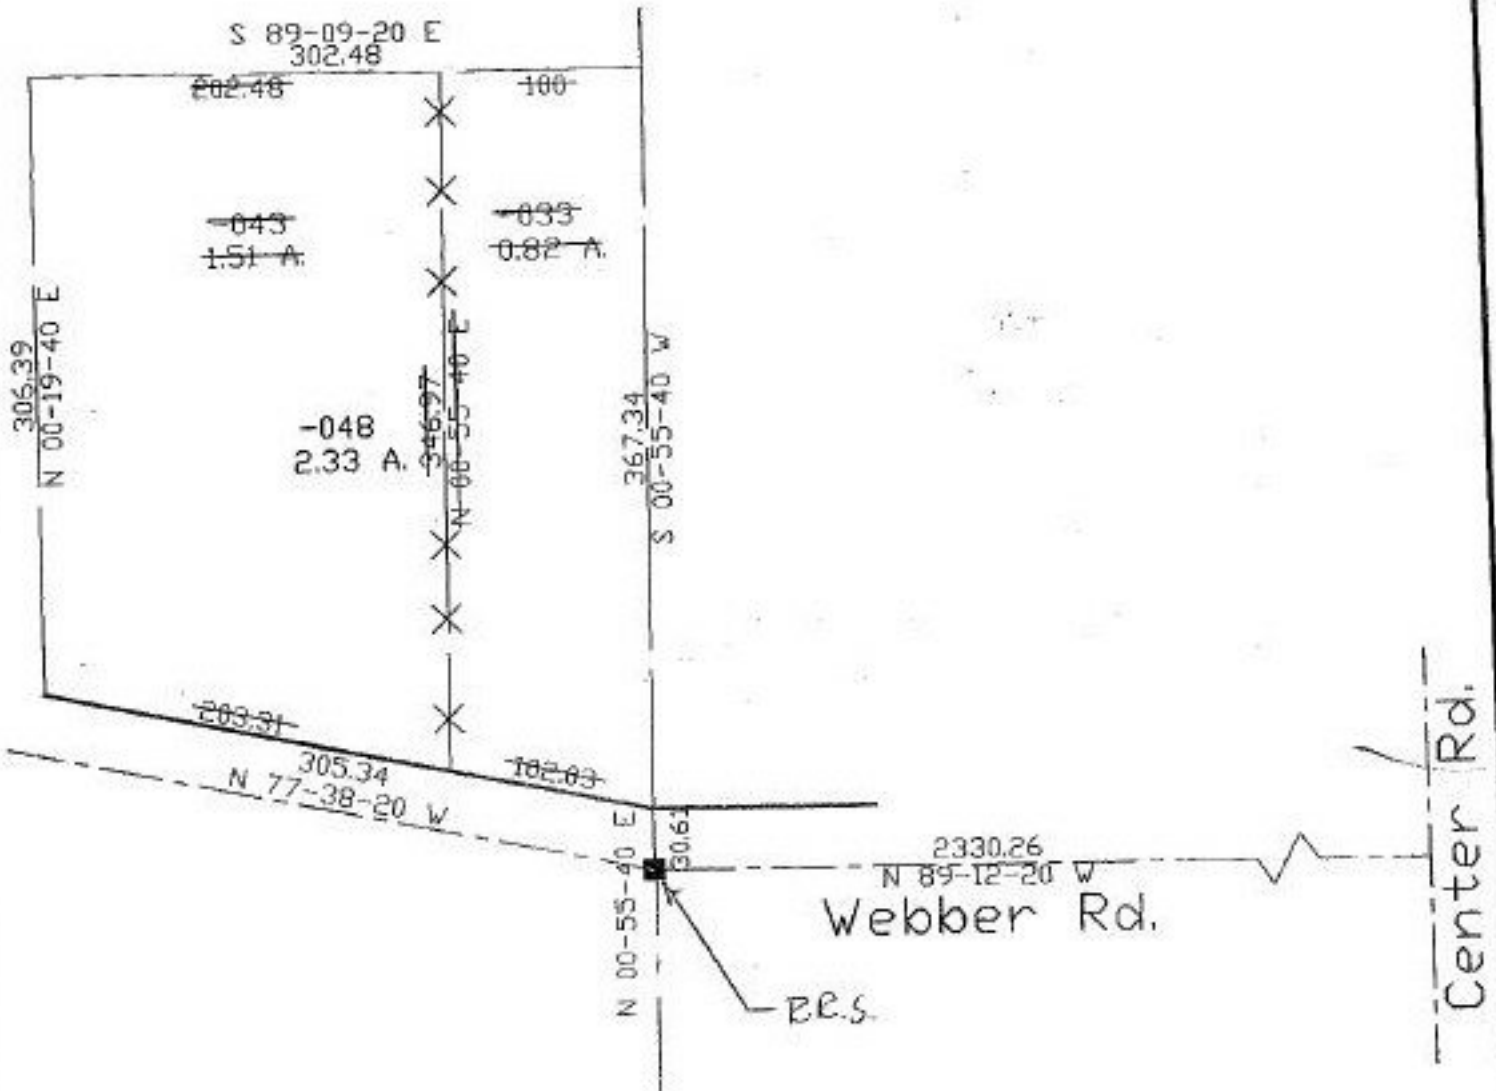

**SPLITS/DEEDS PROCESSED**  
LORAIN COUNTY TAX MAP DEPARTMENT  
228 MIDDLE AVE. ELYRIA, OHIO

SURVEYED BY: James A. Resor  
CLOSURE: 0.07:10.000  
MAP PAGE(S): 4-B APPROVED BY: koc  
DATE: 10/17/97 SCALE: 1" = 100'  
PRIOR INSTRUMENT: OR 517/533 DV 1154/445