


PARENT PARCEL: 09-00-048-000-004  
CHILD PARCEL: 09-00-048-000-006, 007  
STARTING POINT: c.l. of Oberlin Rd. & N. line of O.L. 48

NO. 22320

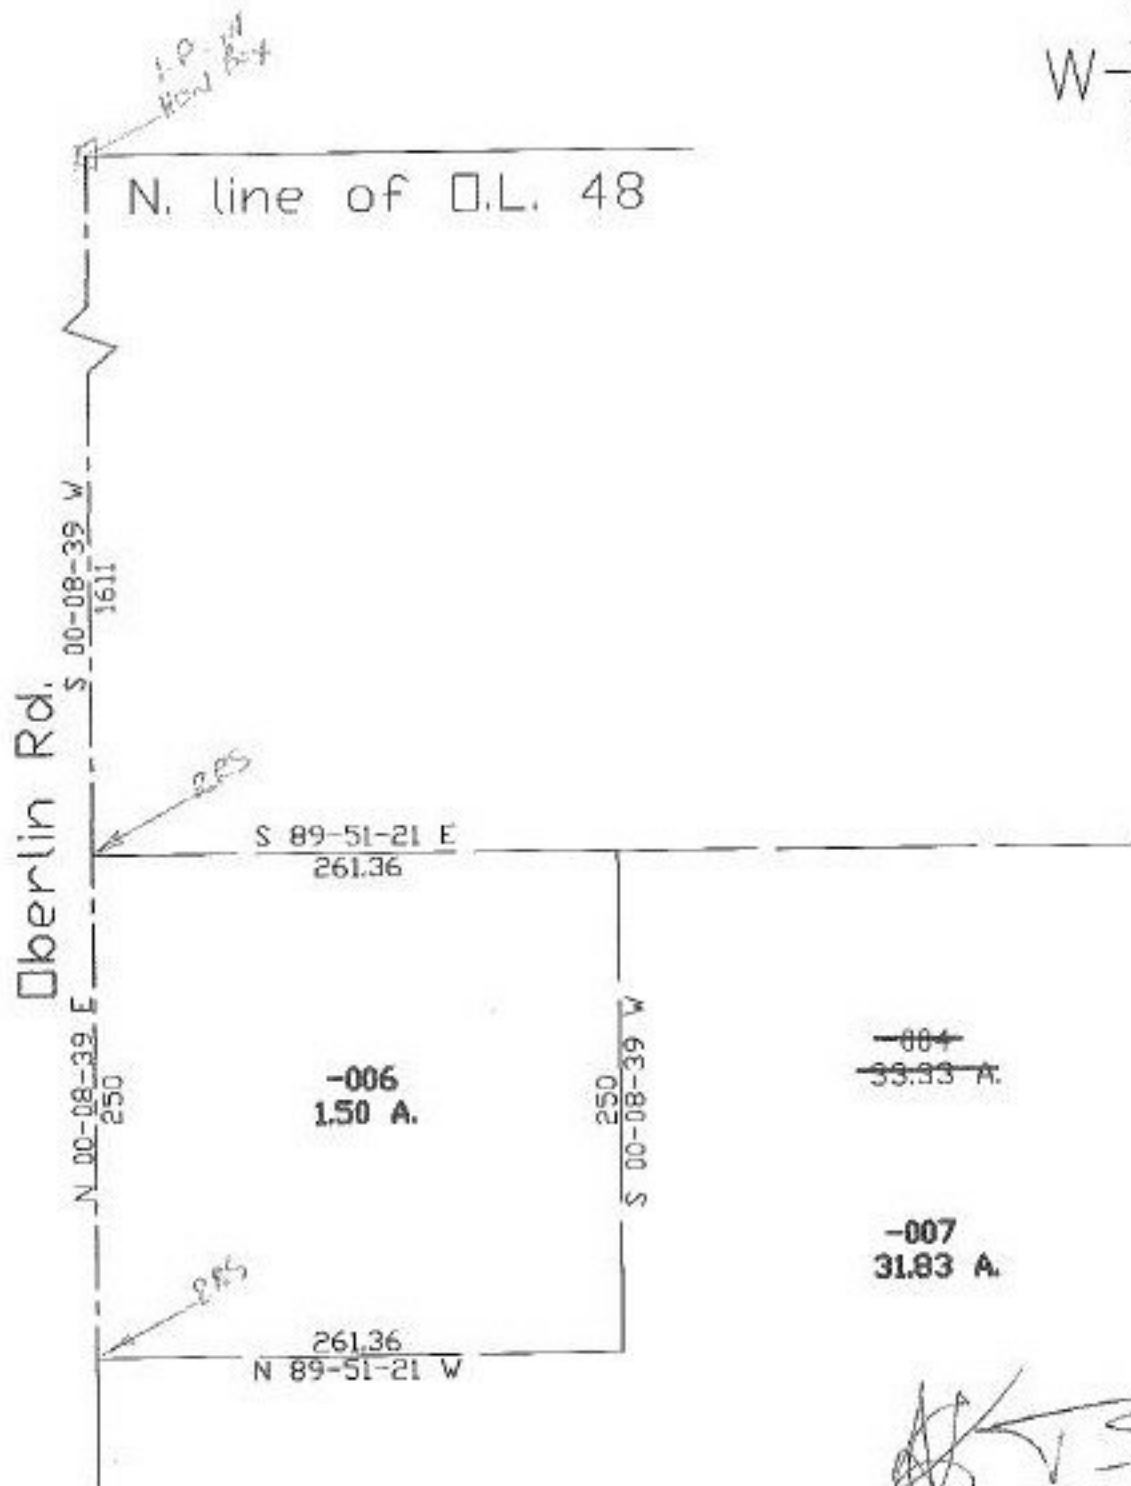

SPLITS/DEEDS PROCESSED  
LORAIN COUNTY TAX MAP DEPARTMENT  
226 MIDDLE AVE. ELYRIA, OHIO

SURVEYED BY: Lowell E. Bender  
CLOSURE: 0.00:10.000  
MAP PAGE(S): 9-0  
APPROVED BY: koc DATE: 10/18/97  
SCALE: 1"=100 PRIOR INSTRUMENT: 447/562