


#22321

NO. 22321

PARENT PARCEL: 03-00-072-000-002
CHILD PARCEL: 03-00-072-000-036, 037
STARTING POINT: c.L. of Gulf Rd. & N. line of O.L. 72

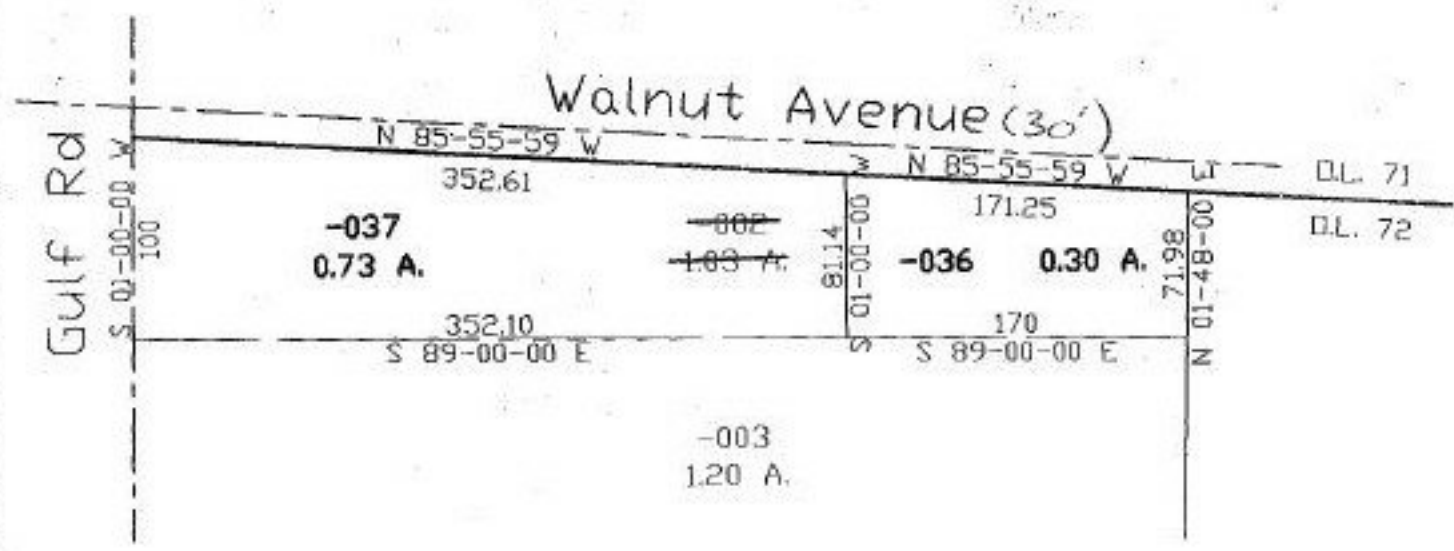

SPLITS/DEEDS PROCESSED
LORAIN COUNTY TAX MAP DEPARTMENT
226 MIDDLE AVE. ELYRIA, OHIO

SURVEYED BY: Douglas H. Mosley
CLOSURE: 0.09:10.000
MAP PAGE(S): 03-00-071-A
APPROVED BY: kac DATE: 10/18/97
SCALE: 1" = 100' PRIOR INSTRUMENT: 1228/852