


PARENT PARCEL: 08-12-013-000-004

CHILD PARCEL: 08-12-013-000-017, 018

STARTING POINT: cl. of Bates Rd. & cl. of Gore-Orphanage Rd.

NO. 22323

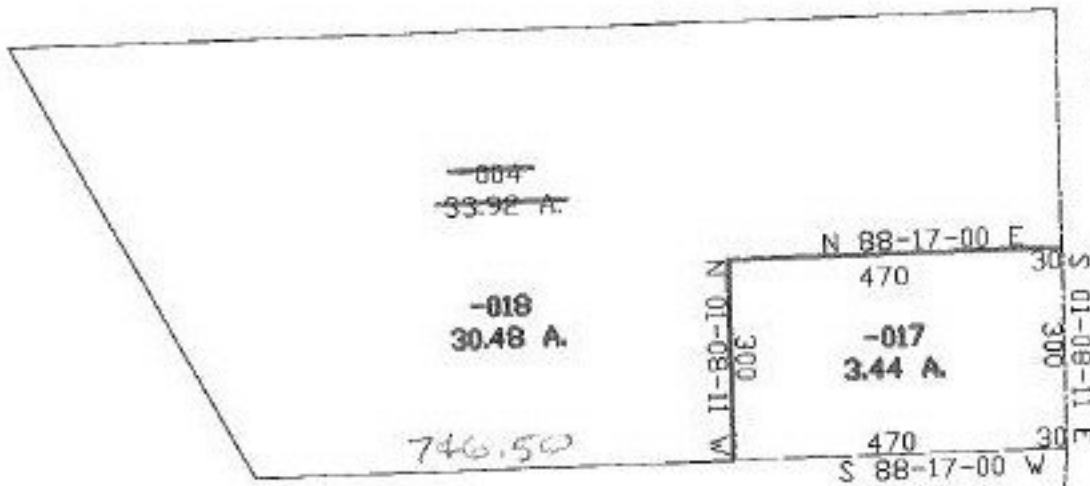

1216.50  
 470.00  
 -----  
 746.50

Gore-Orphanage Rd.

Baird Rd.

Bates Rd.

I.P. IN HOW. Box

I.P. IN HOW

2-18-98



**SPLITS/DEEDS PROCESSED**  
 LORAIN COUNTY TAX MAP DEPARTMENT  
 226 MIDDLE AVE. ELYRIA, OHIO

SURVEYED BY: Patrick McGannon  
 CLOSURE: 0.00:10.000  
 MAP PAGE(S): 8-E  
 APPROVED BY: kpc DATE: 10/23/97  
 SCALE: 1" = 300' PRIOR INSTRUMENT: OR 1332/363