


#22327
NO. 22327

PARENT PARCEL: 02-01-003-501-036, 037
CHILD PARCEL: 02-01-003-142-017, 018 and 02-01-003-501-049
STARTING POINT: c.l. of 14th Street & easterly line of Broadway

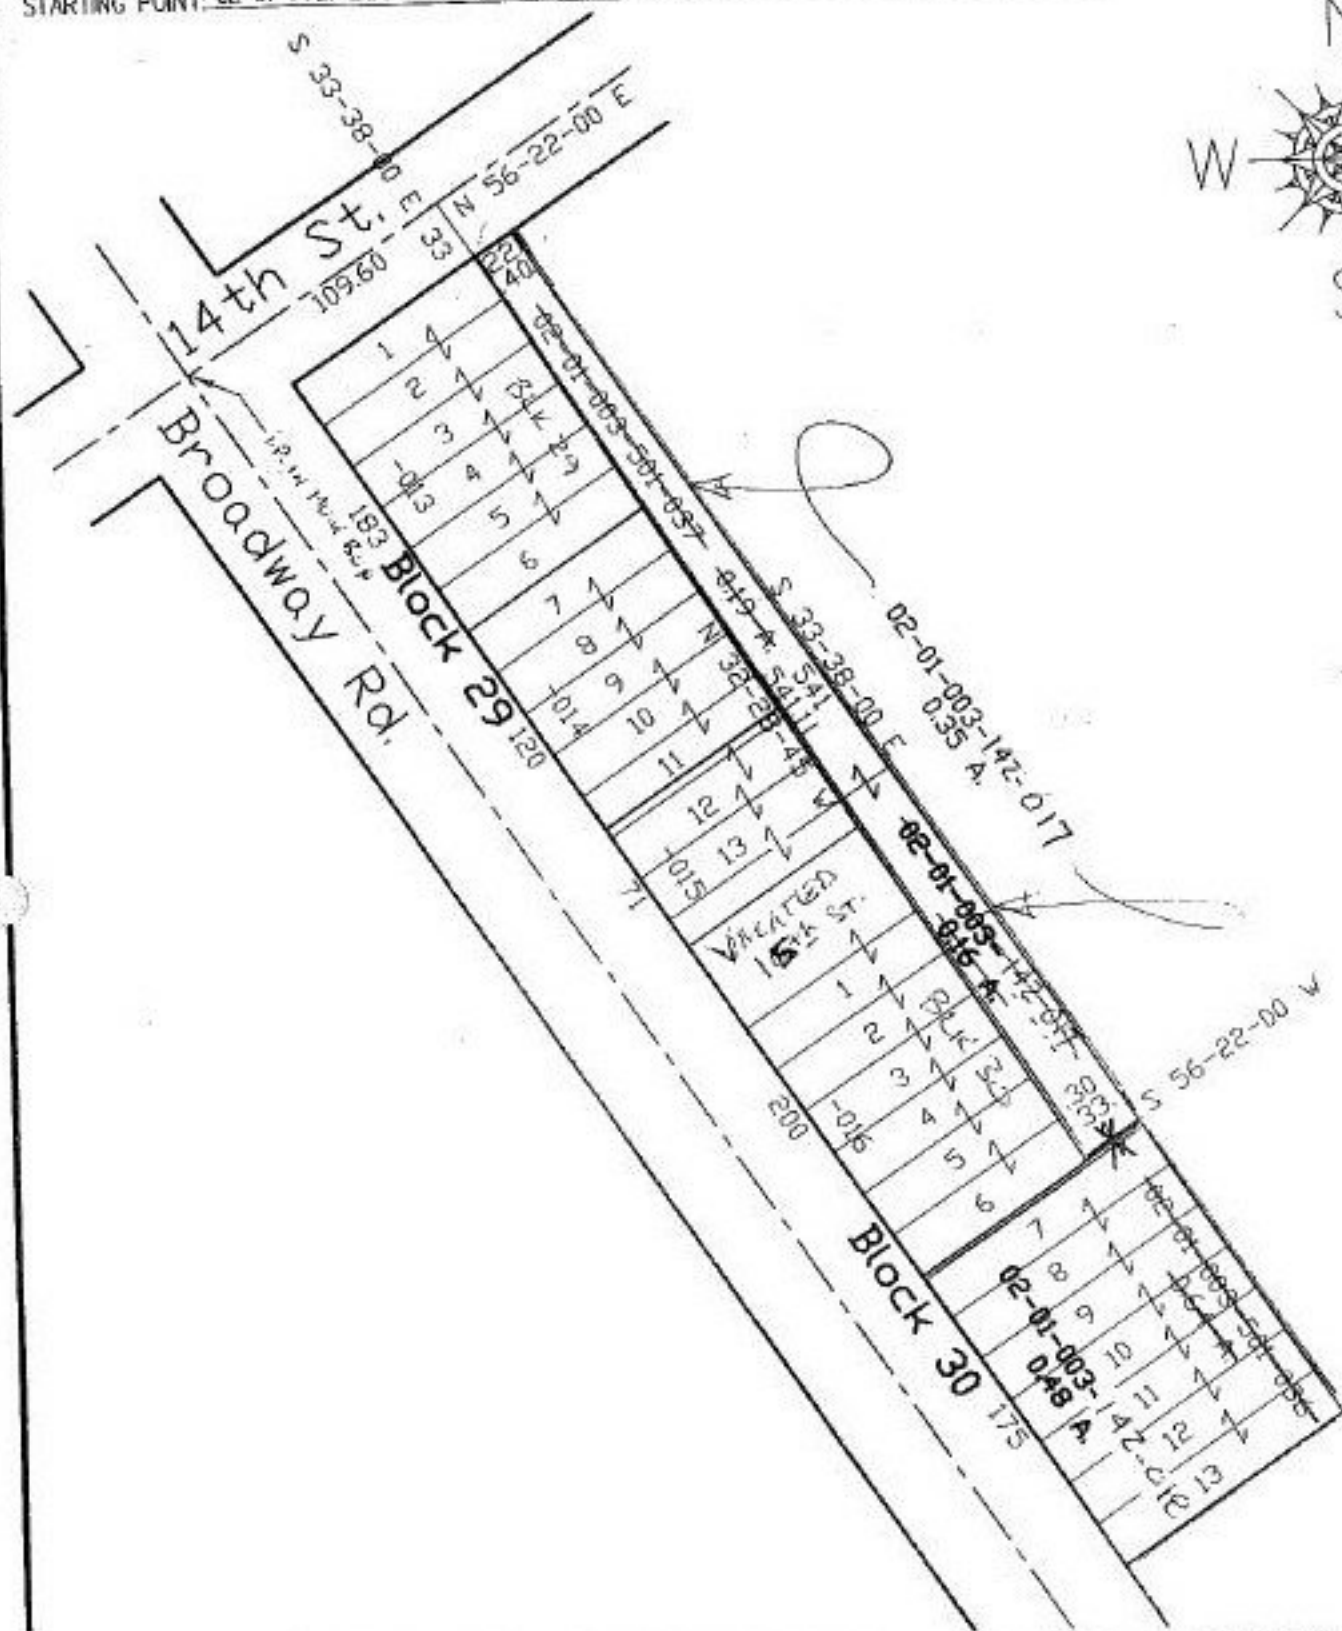

SPLITS/DEEDS PROCESSED
LORAIN COUNTY TAX MAP DEPARTMENT
226 MIDDLE AVE. ELYRIA, OHIO

SURVEYED BY: Patrick A. McGowan
CLOSURE: 0.01:10.000
MAP PAGE(S): 02-01-003-F
APPROVED BY: kac DATE: 10/23/97
SCALE: 1" = 100' PRIOR INSTRUMENT: 22327-1A