

BRANCH


At. PILES CRACK
WEST
CONDO PLAT
47/29-32

900

-002

0.62 A.

CIRC

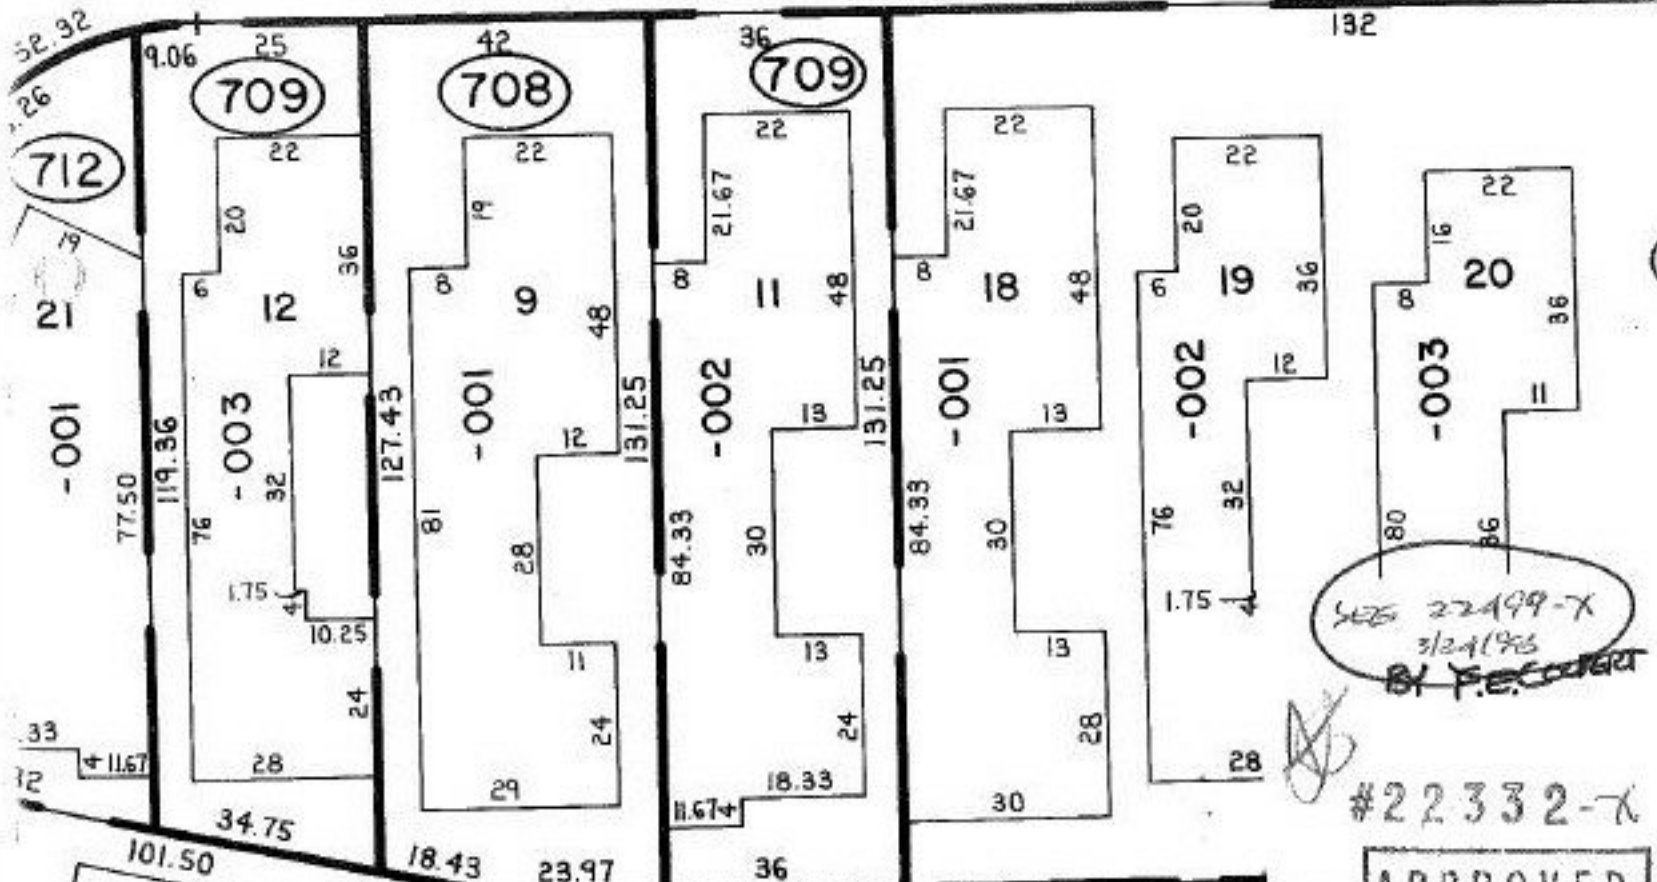

22499-X
3/24/96
BY P. P. WILSON

#22332-X

APPROVED
 LORAIN CO.
 MAP DEPT.
 DATE 10-3-97
 PER 700-007-D-1
 BY Tim Stein
 22332-X

P.P. WILSON