

#22333

NO. 22333

PARENT PARCEL: 04-00-019-101-033



CHILD PARCEL: 04-00-019-101-052, 053

STARTING POINT: cl. of S.R. 6 & cl. of Harvey Pky.



LAKE CLEVELAND SANDUSKY (S.R. 6)

(50') S

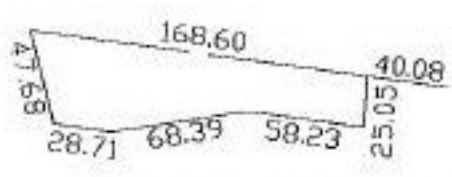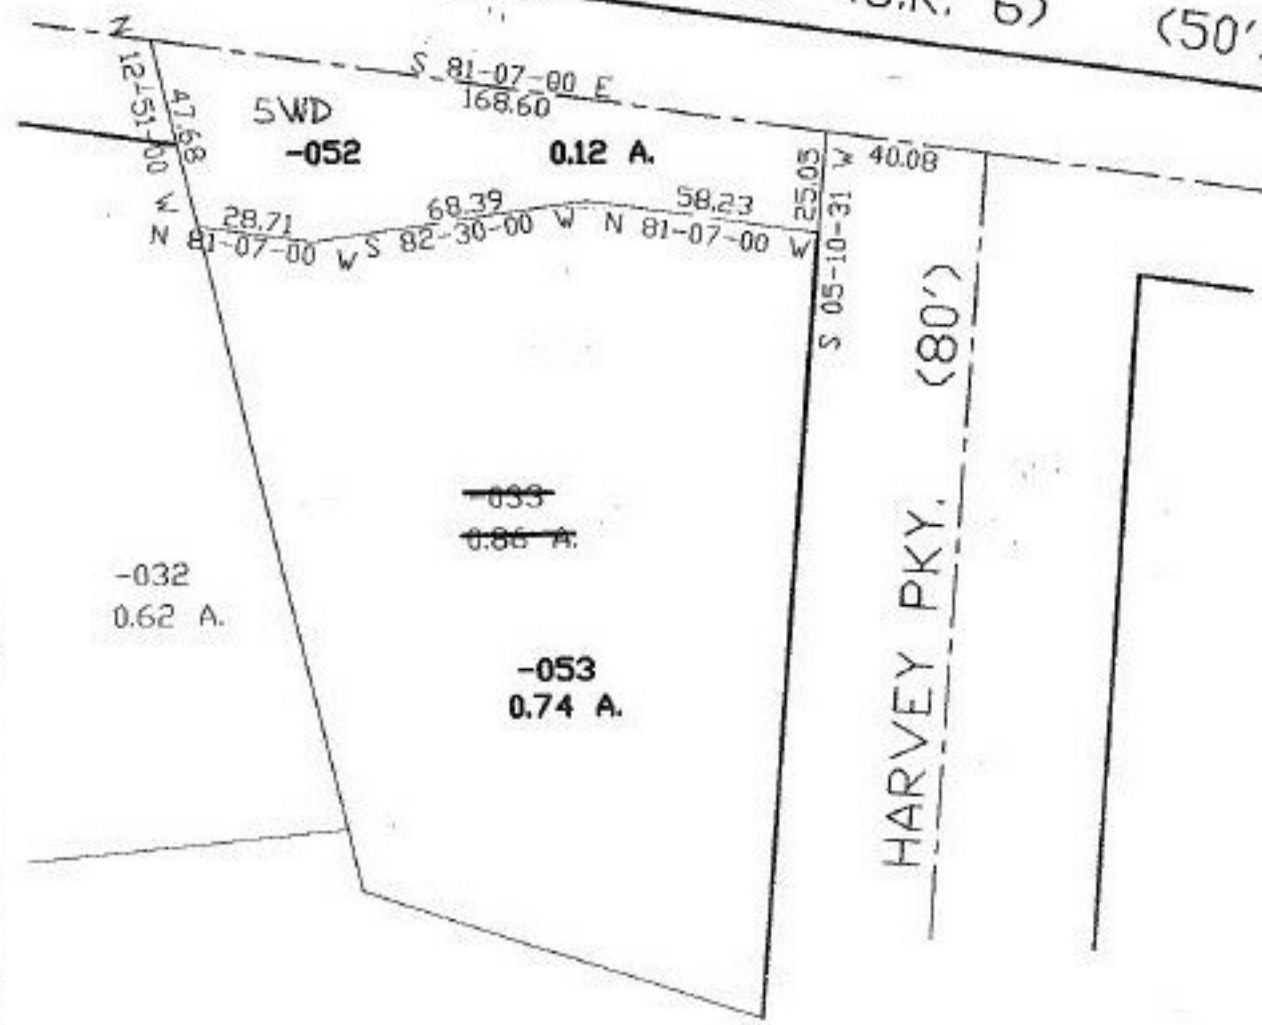

SCALE: 1"=100'



SPLITS/DEEDS PROCESSED
LORAIN COUNTY TAX MAP DEPARTMENT
226 MIDDLE AVE. ELYRIA, OHIO

SURVEYED BY: 000T
CLOSURE: 0.30:10,000
MAP PAGE(S): 04-00-019-B
APPROVED BY: koc DATE: 10/27/97
SCALE: 1"=50' PRIOR INSTRUMENT: 1157/288