


DETAIL SCALE 1" = 50'

GROVE AVE.

GARY AVE.

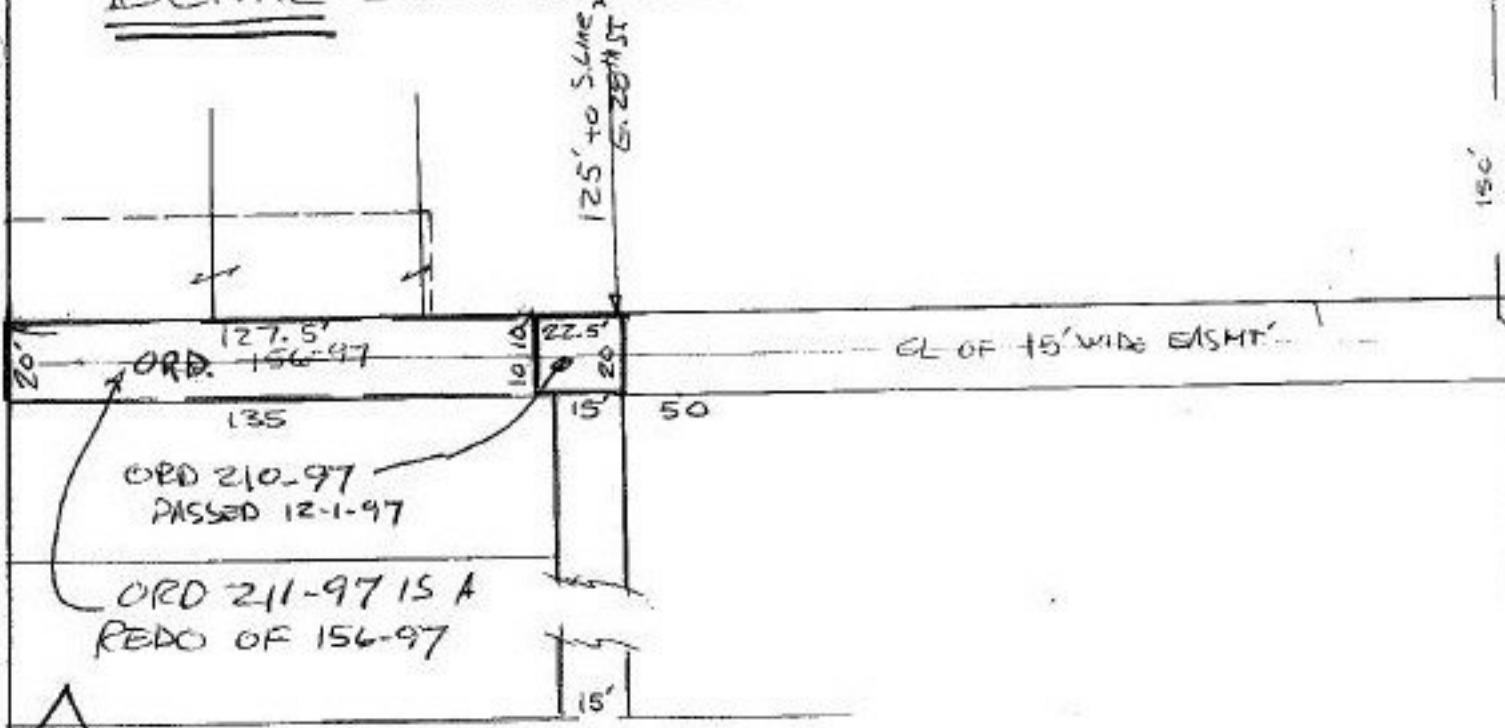

SEE DETAIL

80	28th										80					
100.41	125	2069-001	50	2068-002	2067-013	2066-004	2065-005	2064-006	105	2063-007	2062-008	2061-009	2060-010	2059-011	2058-012	125
25	100.11	-003	49.89	VAC. 21-97												

40	135	2070-001	40	40	2071-002	40	40	2072-003	70	135	7.5	50	150	2073-004	2074-005	2075-006	108	2076-007	2077-008	2078-009	0	2079-010	2080-011	50	2081-012	150	20
VAC. 21-97																VAC. 21-97											

003 150 7.5 x 150.00
 VACATED ORD. 8-91 PASSED 1-22-91
 OK AS IS

80	29th										80			
70	135	2163-001	70	15	50	2162-007	142	2161-008	2160-009	2159-010	2158-011	2157-012	2156-013	109
40	40	2164-002	40	16	2165-003	2162-007	2161-008	2160-009	2159-010	2158-011	2157-012	2156-013	2155-014	

APPROVED
 LOBAIN CO.
 MAP DEPT.
 02-14-00
 2155-014
 T. McNeil
 #22334-V