

PARENT PARCEL: 08-00-091-000-032


CHILD PARCEL: 08-00-091-000-057, 058

STARTING POINT: cl. of Gifford Rd & cl. of State Route 113 (Milan-Elyria Rd.)

NO. 22336



Handwritten scribbles

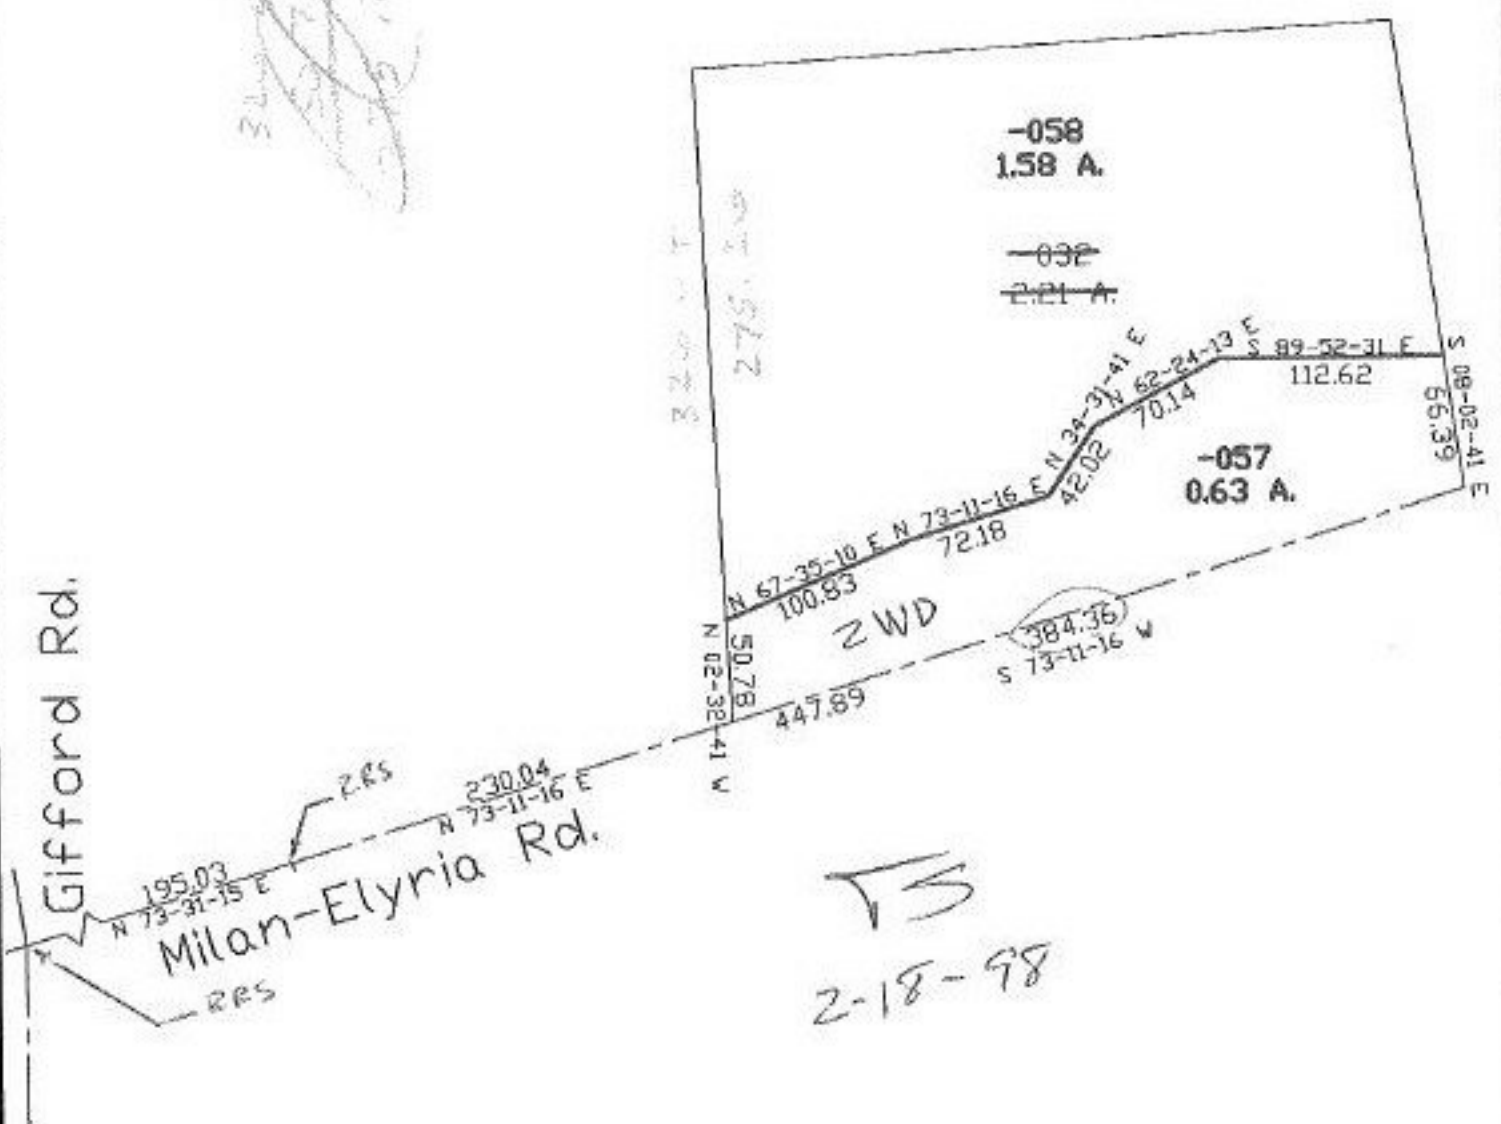

SPLITS/DEEDS PROCESSED
 LORAIN COUNTY TAX MAP DEPARTMENT
 226 MIDDLE AVE. ELYRIA, OHIO

SURVEYED BY: ODOT Ramona Robinson
 CLOSURE: 0.28:10,000
 MAP PAGE(S): 8-C
 APPROVED BY: koc DATE: 10/30/97
 SCALE: 1" = 100' PRIOR INSTRUMENT: OR 99, P.29