


SEE 6-139

#22338-D

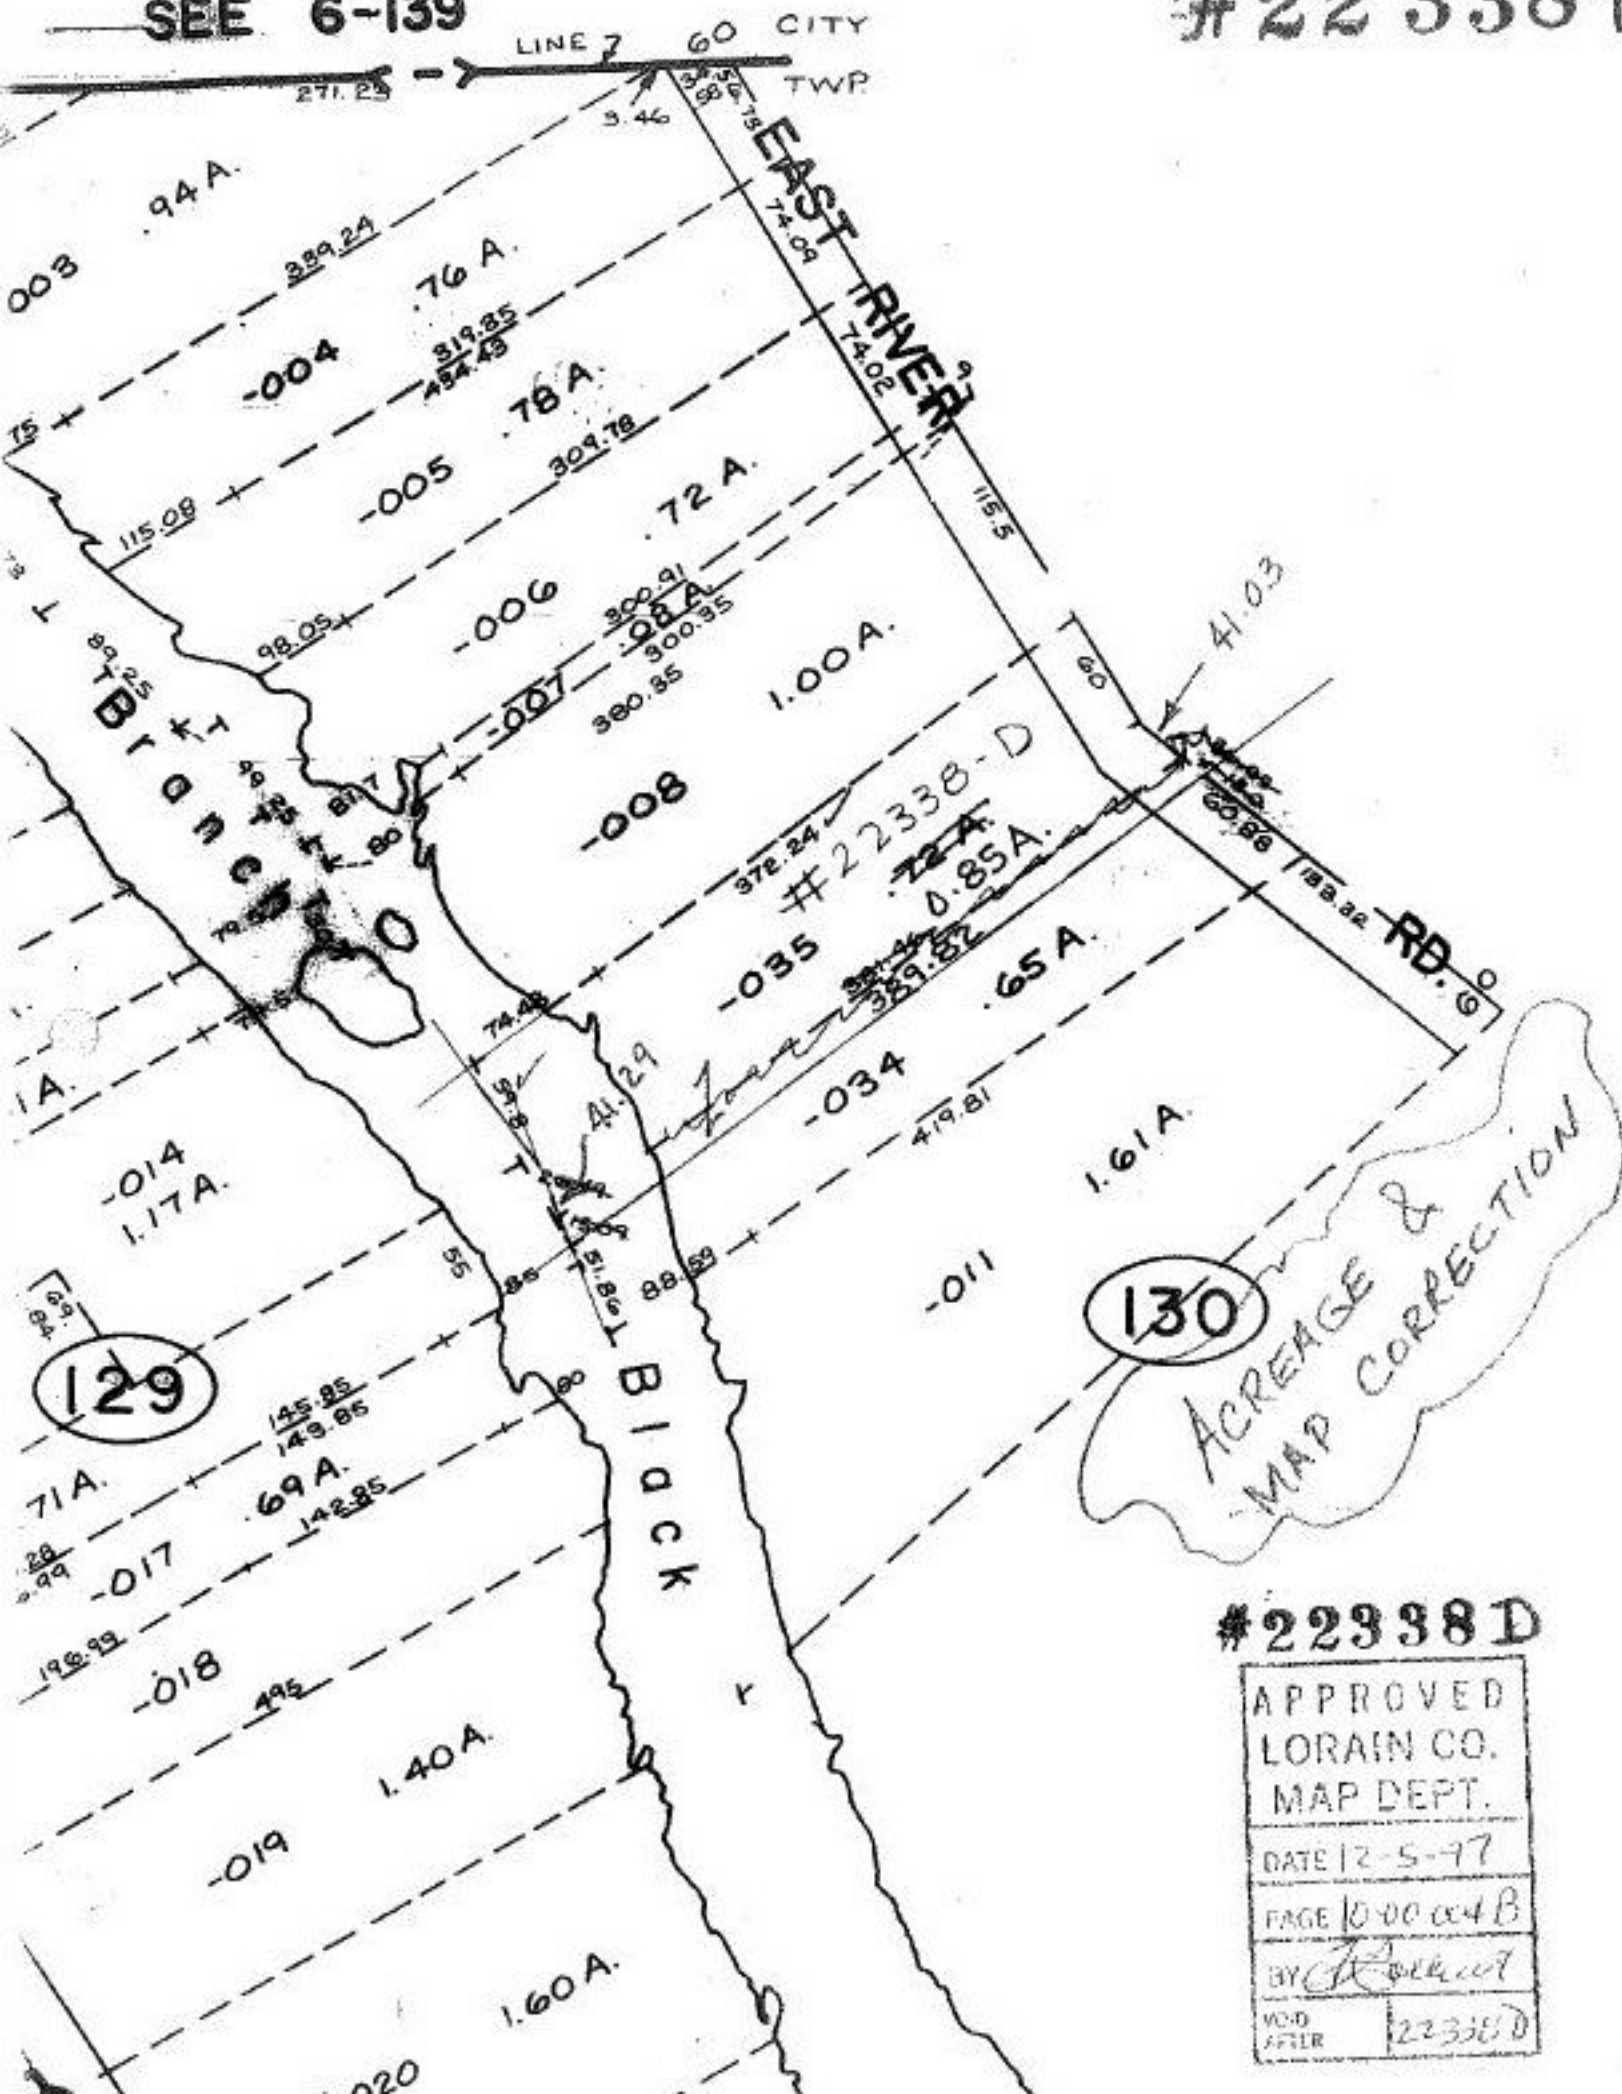

#22338D

APPROVED	
LORAIN CO.	
MAP DEPT.	
DATE 12-5-77	
PAGE 1000 of 4B	
BY <i>[Signature]</i>	
VOID AFTER	22338D